

MAR 03 1998

SECTION

LAND CORNER RECORDATION CERTIFICATE
Filing Requirement of Act 74, Mich. P.A. 1970
KENT COUNTY REMONUMENTATION

For corners in

Table with columns: Kent (County), Located in: Ada Township, Corner Code #. Rows include Public Land Survey, Property Controlling in Section, and Miscellaneous Property in Sec.

STATE OF MICHIGAN
COUNTY OF KENT
RECORDED FOR RECORD
97 OCT 15 AM 8:50
REG. OF DEEDS

10197

Register of Deeds Stamp & File Number


- 4. Lot No.
5. Private Claims

I, Randy Kolehouse, in a field survey on April 1 19 97, do hereby certify that under requirements of P.A. 74 Michigan P.A. of 1970, the corner points mentioned in lines 1 and 2 above were in conformance with regulations and rules therefore as required in the current manual of survey instructions of the United States Department of the interior, Bureau of Land Management or by a decree of a Court of Law and/or that the corner points mentioned in lines 3, 4 and 5 above were in conformance with the rules of the Michigan Board of Land Surveyors or by a Decree of a Court of Law; established, re-established, monumented, re-monumented, recovered, found as expressed below:

NOTE: Not more than 4 corners, all in the same town and range, may be recorded on this certificate.

A. Description of original monument and accessories and/or subsequent restoration:

Table with columns: F-3, 1831-1989, G.L.O. Notes, Mullett, Set Post, Stone, "T" Iron, Fnd. "T" Iron / Set K.C. Monument, K.C. Monument, P.A. 345 1990 KENT COUNTY, PEER APPROVED 6/26/97, CHAIRMAN Randy Kolehouse

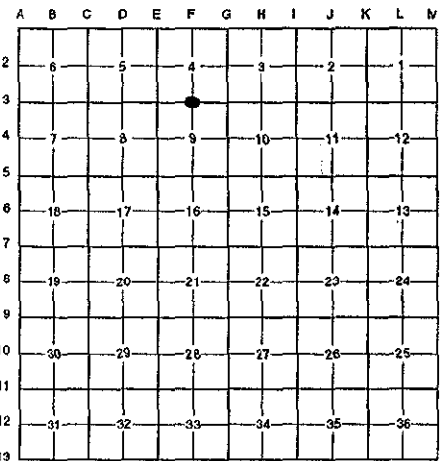

This corner was originally approved by the Kent County Remonumentation Peer Group and monumented by Rob Jonker on 12/15/81 and was recorded per L.C.R.C. #2581.

B. Description of corner evidence found and/or method applied in restoring or reestablishing corner:

F-3 Found a Standard Kent County Monument 1' below grade on the C/L of 3 Mile Road (gravel) on line of a fence line running North per L.C.R.C.'s #2581 and #5137 as set by Rob Jonker in place of a "T" iron he found at grade over stone 35" below grade which checked L.C.R.C. #725, #551 and the K.C. Surveyor's records.

L.C.R.C. #2581

L.C.R.C. #5137

Remon. tag on W side 8" Hickory S 03° E 36.01'
Remon. tag on SE side 8" Hickory S 46° W 38.34'
Remon. tag on NW side 12" W. Cherry N 61° E 71.52'
Remon. tag on E side 26" Hickory N 05° E 56.16'

K.C. Remon. Tag & Nail E side 24" Hickory N 07° E 56.41' (m. 56.10')
K.C. Remon. Tag & Nail NW side 13" Wild Cherry N 63° E 71.49'
K.C. Remon. Tag & Nail W side 9" Hickory S 02° E 36.01' (m. 36.06')
K.C. Remon. Tag & Nail SE side 8" Hickory S 42° W 38.39' (m. 38.39')
K.C. Remon. Tag & Nail SW side 11" Elm N 44° W 69.94'

The selected location is accepted by me and is generally accepted by professional surveyors as the best available evidence of the position of the original corner.

C. Description of monument for corner and accessories established to perpetuate locating the position of the corner:

F-3 Standard Kent County Monument

Nail & K.C. remon. tag on E side 24" Hickory N 07° E 56.10'
Nail & K.C. remon. tag on NW side 14" Cherry N 63° E 71.49'
Nail & K.C. remon. tag on W side 10" Hickory S 02° E 36.06'
Nail & K.C. remon. tag on SE side 8" Hickory S 42° W 38.39'
Nail & K.C. remon. tag on SW side 12" Elm N 44° W 69.94'



Signed by Randy J. Kolehouse Date 8-1-97

EARTH TECH

Surveyor's Michigan License No. 25854