

**SURVEY & REMONUMENTATION**

APR 28 1995

**COMMISSION**

**LAND CORNER RECORDATION CERTIFICATE**  
Filing Requirement of Act 74, Mich. P.A. 1970

STATE OF MICHIGAN  
COUNTY OF KENT  
RECEIVED FOR RECORD  
94 DEC 28 PM 3:04


*Lucy J. Bond*  
REG. OF DEEDS

For corners in

<u>Kent</u> (County)	Located In:	Corner Code #
Ada Township		
1. Public Land Survey	T <u>7N</u> R <u>10W</u>	<u>F-4</u>
	T _____ R _____	<u>Center</u>
	T _____ R _____	<u>Section 9</u>
	T _____ R _____	_____
2. Property Controlling in Section	S _____ T _____ R _____	_____
	S _____ T _____ R _____	_____
3. Miscellaneous Property in Sec.	S _____ T _____ R _____	_____
	S _____ T _____ R _____	_____

**7929**  
Register of Deeds Stamp & File Number

4. Lot No. \_\_\_\_\_, Recorded Plat \_\_\_\_\_  
5. Private Claims \_\_\_\_\_

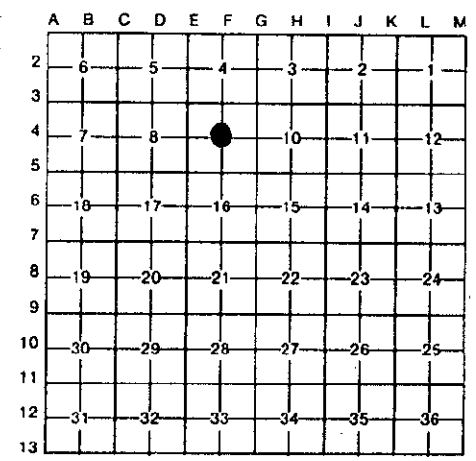

Thomas W. Chettleburgh, in a field survey on December 16, 1994, do hereby certify that under requirements of P.A. 74, Michigan P.A. of 1970, the corner points mentioned in lines 1 and 2 above were in conformance with regulations and rules therefore as required in the current manual of survey instructions of the United States Department of the Interior, Bureau of Land Management or by a decree of a Court of Law and/or that the corner points mentioned in lines 3, 4 and 5 above were in conformance with the rules of the Michigan Board of Land Surveyors or by a Decree of a Court of Law; established, re-established, monumented, re-monumented, recovered, found as expressed below:

**NOTE: Not more than 4 corners, all in the same town and range, may be recorded on this certificate.**

- A. Description of original monument and accessories and/or subsequent restoration:  
 Corner post not set by U.S. Government Land Surveys  
 Williams & Works 1972 Set "T" iron at intersection of 1/4 lines  
 Williams & Works 1974 Found "T" iron as set above, recorded L.C.R.C. #715  
 Williams & Works 1981 Found "T" iron as recorded above, recorded L.C.R.C. #2254  
 M. Rosema 1985 Found "T" iron as recorded above, recorded L.C.R.C. #4318


- B. Description of corner evidence found and/or method applied in restoring or reestablishing corner:  
 Found "T" iron as recorded & witnessed above  
 "T" iron is 0.2' N & 2.2' E of intersection of 1/4 lines  
 Replaced "T" iron with 4" X 30" Harrison Monument

The location of the "T" iron above is accepted by me and is generally accepted by Professional Surveyors as the best position of the corner based on the available evidence.

P.A. 345 1990 KENT COUNTY  
 PEER APPROVED 12/22/94  
 CHAIRMAN *Harry Huber*

- C. Description of monument for corner and accessories established to perpetuate locating the position of the corner:

4" X 30" Harrison Monument				
Nail/tag	SE side	9" Elm	N49°E	52.78'
Nail/tag	W side	Power Pole	S22°W	42.15'
Nail/tag	S side	20" Oak	N70°W	86.35'
Nail/tag	SW side	22" Oak	N52°W	46.31'
Nail/tag	SW side	16" Oak	N30°W	33.23'
Centerline East-West pavement, Knapp Street			North	4.6'

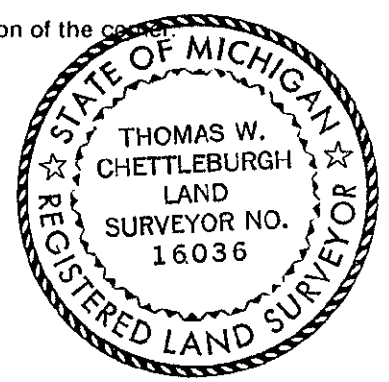

Signed by *Thomas W. Chettleburgh* Date December 27, 1994  
 Surveyor's Michigan License No. 16036