

**SURVEY &
REMONUMENTATION**

MAR 03 1998

~~\$7.00~~
~~\$2.00~~

SECTION LAND CORNER RECORDATION CERTIFICATE
Filing Requirement of Act 74, Mich. P.A. 1970
KENT COUNTY REMONUMENTATION

STATE OF MICHIGAN
COUNTY OF KENT
RECEIVED FOR RECORD
97 DEC 15 AM 10:42
REG. OF DEEDS
Lucy Standa

For corners in Kent (County) Located in: Ada Township Corner Code #


1. Public Land Survey	T <u>7N</u>	R <u>10W</u>	<u>F-6</u>
	T _____	R _____	_____
	T _____	R _____	_____
	T _____	R _____	_____
2. Property Controlling in Section	S _____	T _____	R _____
	S _____	T _____	R _____
3. Miscellaneous Property in Sec.	S _____	T _____	R _____
	S _____	T _____	R _____

4. Lot No. _____, Recorded Plat _____
5. Private Claims _____

10360

Register of Deeds Stamp & File Number

I, Randy Kolehouse, in a field survey on August 5, 19 97, do hereby certify that under requirements of P.A. 74 Michigan P.A. of 1970, the corner points mentioned in lines 1 and 2 above were in conformance with regulations and rules therefore as required in the current manual of survey instructions of the United States Department of the interior, Bureau of Land Management or by a decree of a Court of Law and/or that the corner points mentioned in lines 3, 4 and 5 above were in conformance with the rules of the Michigan Board of Land Surveyors or by a Decree of a Court of Law; established, re-established, monumented, re-monumented, recovered, found as expressed below:

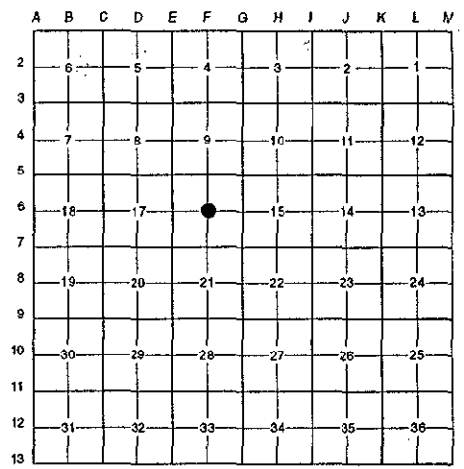

NOTE: Not more than 4 corners, all in the same town and range, may be recorded on this certificate.

A. Description of original monument and accessories and/or subsequent restoration:

F-6 This corner was not originally set by the G.L.O.

1967	Survey Notes	Williams & Works	Set "T" Iron @ Intersection of 1/4 Lines
1967	Witness Map	K.C. Surveyor	Iron
1974	L.C.R.C. #1087	Medema, Van Kooten & Assoc.	"T" Iron

B. Description of corner evidence found and/or method applied in restoring or reestablishing corner:

F-6 Found a "T" iron 13' North and 40' West of an old wire fence per L.C.R.C.'s #1087 and the K.C. Surveyor's as set by Williams & Works in 1967. "T" iron was 0.5' North and 0.4' East of the intersection of 1/4 lines. Decided to set monument at the intersection of 1/4 lines.


P.A. 345 1990 KENT COUNTY
PEER APPROVED 9/25/97
CHAIRMAN *[Signature]*

The selected location is accepted by me and is generally accepted by professional surveyors as the best available evidence of the position of the original corner.

C. Description of monument for corner and accessories established to perpetuate locating the position of the corner:

F-6 Set a Standard Kent County Monument

- Nail & K.C. remon. tag on E side 16" Oak N 45° E 12.85'
- Nail & K.C. remon. tag on N side 14" Maple S 70° E 27.25'
- Nail & K.C. remon. tag on W side 8" Maple S 10° W 13.96'
- Nail & K.C. remon. tag on N side 10" Oak S 65° W 15.93'

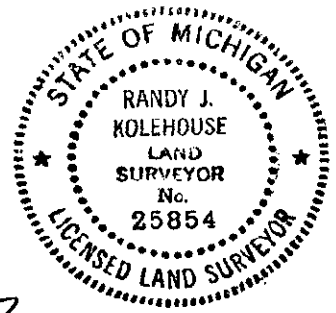

Signed by *Randy J. Kolehouse* Date 12/5/97
EARTH TECH
Surveyor's Michigan License No. 25854