

**SURVEY & REMONUMENTATION**

MAR 03 1998

\$7.00  
\$2.00

SECTION

**LAND CORNER RECORDATION CERTIFICATE**  
Filing Requirement of Act 74, Mich. P.A. 1970  
KENT COUNTY REMONUMENTATION

STATE OF MICHIGAN  
COUNTY OF KENT  
RECEIVED FOR RECORD  
97 DEC 15 AM 10:42  
REG. OF DEEDS  
*W. J. Bond*

10361


Register of Deeds Stamp & File Number

For corners in Kent (County)

	Located in:	Ada Township	Corner Code #
1. Public Land Survey	T <u>7N</u> R <u>10W</u>		<u>F-8</u>
	T _____ R _____		_____
	T _____ R _____		_____
	T _____ R _____		_____
2. Property Controlling in Section.	S _____ T _____ R _____		_____
	S _____ T _____ R _____		_____
3. Miscellaneous Property in Sec.	S _____ T _____ R _____		_____
	S _____ T _____ R _____		_____

4. Lot No. \_\_\_\_\_, Recorded Plat \_\_\_\_\_

5. Private Claims \_\_\_\_\_

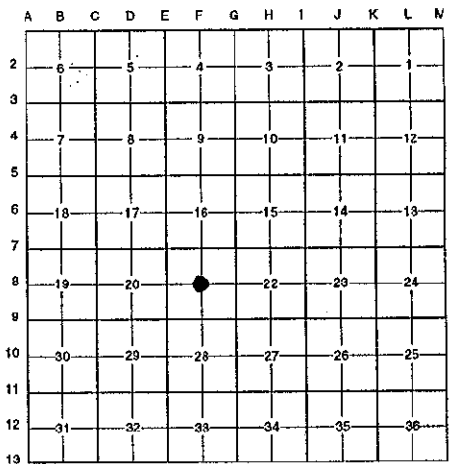

I, Randy Kolehouse, in a field survey on January 29 19 97, do hereby certify that under requirements of P.A. 74 Michigan P.A. of 1970, the corner points mentioned in lines 1 and 2 above were in conformance with regulations and rules therefore as required in the current manual of survey instructions of the United States Department of the interior, Bureau of Land Management or by a decree of a Court of Law and/or that the corner points mentioned in lines 3, 4 and 5 above were in conformance with the rules of the Michigan Board of Land Surveyors or by a Decree of a Court of Law; established, re-established, monumented, re-monumented, recovered, found as expressed below:

NOTE: Not more than 4 corners, all in the same town and range, may be recorded on this certificate.

A. Description of original monument and accessories and/or subsequent restoration:

F-8 This corner was not originally set by the G.L.O.

1940	Witness Map	K.C. Surveyor	Concrete Monument	P.A. 345 1990 KENT COUNTY
1976	L.C.R.C. #1012	Medema, Van Kooten & Assoc.	Concrete Monument	PEER APPROVED <u>9/25/97</u>

CHAIRMAN *[Signature]*

B. Description of corner evidence found and/or method applied in restoring or reestablishing corner:

F-8 Found a 1" iron bar in a concrete monument at the C/L point of intersection of Conservation Street (gravel) running South and East per L.C.R.C. #1012 and the K.C. Surveyor's records. Concrete monument is 0.3' North and 0.6' West of the intersection of 1/4 lines. Accepted concrete monument as Center of Section.


K.C. Witness Map	L.C.R.C. #1012
C.P. pole SE 97.2' (Face)	Nail in T. Pole W 50.51'
	Nail in P. Pole SE 97.67'
	"X" on top of W end of culvert S-SW 67.57'

The selected location is accepted by me and is generally accepted by professional surveyors as the best available evidence of the position of the original corner.

C. Description of monument for corner and accessories established to perpetuate locating the position of the corner:

F-8 Replaced Concrete Monument with a Standard Kent County Monument

- Nail & K.C. remon. tag on S side T. pole N 80° W 50.51'
- Nail & K.C. remon. tag on E side P. pole S 25° E 97.73'
- Nail & K.C. remon. tag on S side triple 8" Ash N 55° E 47.17'
- Nail & K.C. remon. tag on SE side 16" Wild Cherry S 72° W 47.77'
- "X" cut top West end conc. culv. S 33° W 67.77'

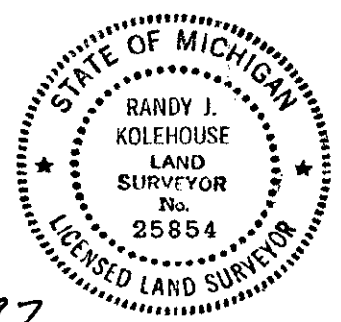

Signed by *Randy J. Kolehouse* Date 11/20/97  
EARTH TECH

Surveyor's Michigan License No. 25854