

SURVEY & REMONUMENTATION

MAR 03 1998

\$7.00
\$2.00

LAND CORNER RECORDATION CERTIFICATE
Filing Requirement of Act 74, Mich. P.A. 1970
KENT COUNTY REMONUMENTATION

STATE OF MICHIGAN
COUNTY OF KENT
RECEIVED FOR RECORD

97 DEC 15 AM 10:42

REC. OF DEEDS

David Stoddard

10362

Register of Deeds Stamp & File Number

For corners in SECTION


Kent (County)	Located in: Ada Township	Corner Code #
1. Public Land Survey	T <u>7N</u> R <u>10W</u>	<u>F-9</u>
	T _____ R _____	_____
	T _____ R _____	_____
	T _____ R _____	_____
2. Property Controlling in Section	S _____ T _____ R _____	_____
	S _____ T _____ R _____	_____
3. Miscellaneous Property in Sec.	S _____ T _____ R _____	_____
	S _____ T _____ R _____	_____

4. Lot No. _____, Recorded Plat _____

5. Private Claims _____

I, Randy Kolehouse, in a field survey on December 3 19 97, do hereby certify that under requirements of P.A. 74 Michigan P.A. of 1970, the corner points mentioned in lines 1 and 2 above were in conformance with regulations and rules therefore as required in the current manual of survey instructions of the United States Department of the interior, Bureau of Land Management or by a decree of a Court of Law and/or that the corner points mentioned in lines 3, 4 and 5 above were in conformance with the rules of the Michigan Board of Land Surveyors, or by a Decree of a Court of law; established, re-established, monumented, re-monumented, recovered, found as expressed below:

NOTE: Not more than 4 corners, all in the same town and range, may be recorded on this certificate.

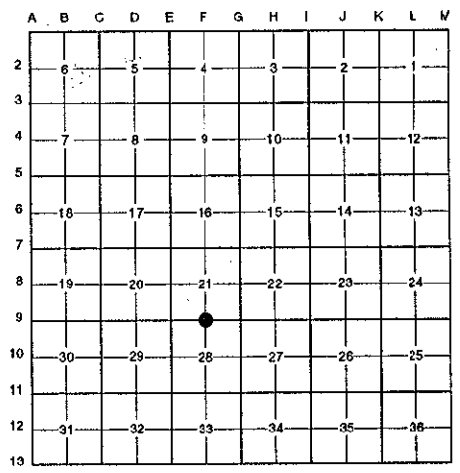

A. Description of original monument and accessories and/or subsequent restoration:

F-9	1971	L.C.R.C. #16	Williams & Works	1/2" Pipe
	1980	L.C.R.C. #1733	Williams & Works	Fnd. 1"x18" Iron & 1"x15" Iron / Set K.C. Monument
	1989	L.C.R.C. #5140	T. Chettleburgh	K.C. Monument

P.A. 345 1990 KENT COUNTY
PEER APPROVED 10/30/97
CHAIRMAN Randy Kolehouse

This corner was originally approved by the Kent County Remonumentation Peer Group and monumented by T. Chettleburgh on 12/22/80 and was recorded per L.C.R.C. #1733.

B. Description of corner evidence found and/or method applied in restoring or reestablishing corner:

F-9 Found a Standard Kent County Monument on the West edge of woods running North and South and 30' East of the C/L of power lines running North and South per L.C.R.C.'s #1733 and #5140 as set by Williams & Works in place of an iron they found using L.C.R.C. #16.


L.C.R.C. #1733	L.C.R.C. #5140
Nail & K.C. Remon. Tag S.W. Side 26" Maple N 35° W 32.00'	K.C. Remon. Tag & Nail NW side 8" Maple N 50° E 34.78'
Nail & K.C. Remon. Tag South Side 10" Maple N 50° E 34.75'	K.C. Remon. Tag & Nail NW side 8" Maple N 66° E 30.47' (m. 30.44')
Nail & K.C. Remon. Tag N.W. Side 8" Maple N 70° E 30.39'	K.C. Remon. Tag & Nail W side 9" Maple S 00° E 56.70' (m. 56.74')
Nail & K.C. Remon. Tag West Side 8" Maple South 56.70'	K.C. Remon. Tag & Nail NE side 27" Maple S 07° W 25.44'
Nail & K.C. Remon. Tag N.E. Side 24" Maple S 05° W 25.47'	K.C. Remon. Tag & Nail N side 15" Maple S 80° W 66.48'
	K.C. Remon. Tag & Nail SW side 21" Maple N 30° W 31.84' (m. 31.85')

The selected location is accepted by me and is generally accepted by professional surveyors as the best available evidence of the position of the original corner.

C. Description of monument for corner and accessories established to perpetuate locating the position of the corner:

F-9 Standard Kent County Monument

Nail & K.C. remon. tag on NW Face 8" Maple N 50° E 34.78'
Nail & K.C. remon. tag on NE Face 8" Maple N 66° E 30.44'
Nail & K.C. remon. tag on W Face 9" Maple S 00° E 56.74'
Nail & K.C. remon. tag on NE Face 27" Maple S 07° E 25.44'
Nail & K.C. remon. tag on SW Face 21" Maple N 30° W 31.85'

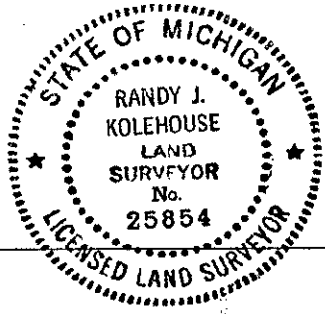

Signed by Randy Kolehouse Date 12/5/97
EARTH TECH
Surveyor's Michigan License No. 25854