

SURVEY & REMONUMENTATION

MAR 03 1998

LAND CORNER RECORDATION CERTIFICATE
Filing Requirement of Act 74, Mich. P.A. 1970
KENT COUNTY REMONUMENTATION

For corners in SECTION
Kent
 (County)

Located in: Ada Corner Code #
 Township

1. Public Land Survey T 7N R 10W G-2
 T _____ R _____
 T _____ R _____
 T _____ R _____
2. Property Controlling S _____ T _____ R _____
 in Section S _____ T _____ R _____
3. Miscellaneous S _____ T _____ R _____
 Property in Sec. S _____ T _____ R _____
4. Lot No. _____, Recorded Plat _____
5. Private Claims _____

STATE OF MICHIGAN
 COUNTY OF KENT
 RECEIVED FOR RECORD
 97 OCT 15 AM 8:51
 REG. OF DEEDS
David J. Bond

10201


Register of Deeds Stamp & File Number

I, Randy Kolehouse, in a field survey on July 10 19 97, do hereby certify that under requirements of P.A. 74 Michigan P.A. of 1970, the corner points mentioned in lines 1 and 2 above were in conformance with regulations and rules therefore as required in the current manual of survey instructions of the United States Department of the Interior, Bureau of Land Management or by a decree of a Court of Law and/or that the corner points mentioned in lines 3, 4 and 5 above were in conformance with the rules of the Michigan Board of Land Surveyors or by a Decree of a Court of Law; established, re-established, monumented, re-monumented, recovered, found as expressed below:

NOTE: Not more than 4 corners, all in the same town and range, may be recorded on this certificate.

A. Description of original monument and accessories and/or subsequent restoration:

| | | | | | |
|-----|------|----------------|-----------------------------|---|---------------------------------|
| G-2 | 1831 | G.L.O. Notes | Mullett | Set Post | P.A. 345 1990 KENT COUNTY |
| | 1964 | Witness Map | K.C. Surveyor | "T" Iron | PEER APPROVED 7/24/97 |
| | 1973 | L.C.R.C. #551 | P. Van Kooten | "T" Iron | CHAIRMAN <i>Randy Kolehouse</i> |
| | 1974 | L.C.R.C. #725 | Medema, Van Kooten & Assoc. | "T" Iron | |
| | 1981 | L.C.R.C. #2584 | Jonker Land Survey | Fnd. "T" Iron by Stones / Set K.C. Monument | |
| | 1989 | L.C.R.C. #5143 | T. Chettleburgh | K.C. Monument in Ring of Stones | |

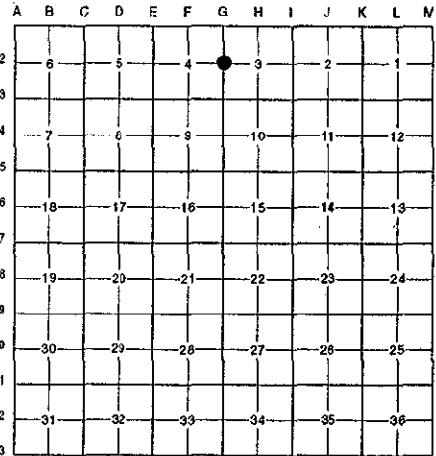

This corner was originally approved by the Kent County Remonumentation Peer Group and monumented by Rob Jonker on 12/21/81 and was recorded per L.C.R.C. #2584.

B. Description of corner evidence found and/or method applied in restoring or reestablishing corner:


| | |
|-----|---|
| G-2 | Found a Standard Kent County Monument in a ring of stones at the South end of trail as it curves to the East and 100' ± North of the C/L of Egypt Creek per L.C.R.C.'s #2584 and #5143 as set by Rob Jonker in place of a "T" iron he found by stones which checked L.C.R.C.'s #725, #551, and the K.C. Surveyor's records. |
| | L.C.R.C. #2584 |
| | L.C.R.C. #5143 |
| | Remon. tag on W side 12" Walnut S 07° W 38.66' |
| | Remon. tag on SE side 20" Oak S 37° W 67.28' |
| | Remon. tag on NE side 10" Walnut N 62° W 36.85' |
| | Remon. tag on NW side 4" Walnut N 55° E 15.10' |
| | S. end of trail as it curves to the east is North 75' m/l |
| | C/L creek, South 100' m/l |
| | South end of trail at point of curve East North 75'± |
| | K.C. Remon. Tag & Nail NW side 6" Walnut N 56° E 15.07' (m. 15.06') |
| | K.C. Remon. Tag & Nail N side 8" Walnut S 79° E 21.94' (m. 21.93') |
| | K.C. Remon. Tag & Nail W side 12" Walnut S 05° W 38.62' (m. 38.70') |
| | K.C. Remon. Tag & Nail SE side 23" Oak S 35° W 67.28' (m. 67.39') |
| | K.C. Remon. Tag & Nail NE side 11" Walnut N 61° W 36.85' (m. 37.00') |
| | K.C. Remon. Tag & Nail E side 9" Walnut N 05° W 38.63' (m. 38.68') |
| | Centerline Creek South 100' ± |

The selected location is accepted by me and is generally accepted by professional surveyors as the best available evidence of the position of the original corner.

C. Description of monument for corner and accessories established to perpetuate locating the position of the corner:

G-2 Standard Kent County Monument

Nail & K.C. remon. tag on NW side 6" Walnut N 56° E 15.06'
 Nail & K.C. remon. tag on N side 8" Walnut S 79° E 21.93'
 Nail & K.C. remon. tag on W side 12" Walnut S 05° W 38.70'
 Nail & K.C. remon. tag on SE side 23" Oak S 35° W 67.39'
 Nail & K.C. remon. tag on NE side 11" Walnut N 61° W 37.00'
 Nail & K.C. remon. tag on E side 9" Walnut N 05° W 38.68'

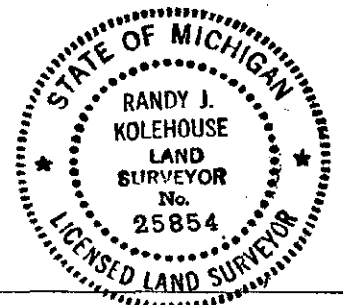

Signed by *Randy J. Kolehouse* Date 8-1-97
 EARTH TECH

Surveyor's Michigan License No. 25854