

SURVEY & REMONUMENTATION

MAR 03 1998

SECTION

LAND CORNER RECORDATION CERTIFICATE
Filing Requirement of Act 74, Mich. P.A. 1970
KENT COUNTY REMONUMENTATION

For corners in

Kent (County)	Located in:	Ada Township	Corner Code #
1. Public Land Survey	T <u>7N</u>	R <u>10W</u>	<u>G-5</u>
	T _____	R _____	_____
	T _____	R _____	_____
	T _____	R _____	_____
2. Property Controlling in Section	S _____	T _____	R _____
	S _____	T _____	R _____
3. Miscellaneous Property in Sec.	S _____	T _____	R _____
	S _____	T _____	R _____

STATE OF MICHIGAN
 COUNTY OF KENT
 REGISTERED FOR RECORD

97 OCT 15 AM 8:51

REG. OF DEEDS


Luis J. Hane

10204

Register of Deeds Stamp & File Number

4. Lot No. _____, Recorded Plat _____
5. Private Claims _____

I, Randy Kolehouse, in a field survey on April 11 19 97, do hereby certify that under requirements of P.A. 74 Michigan P.A. of 1970, the corner points mentioned in lines 1 and 2 above were in conformance with regulations and rules therefore as required in the current manual of survey instructions of the United States Department of the interior, Bureau of Land Management or by a decree of a Court of Law and/or that the corner points mentioned in lines 3, 4 and 5 above were in conformance with the rules of the Michigan Board of Land Surveyors or by a Decree of a Court of Law; established, re-established, monumented, re-monumented, recovered, found as expressed below:

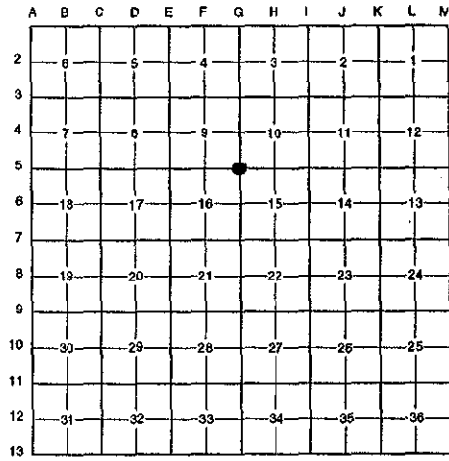

NOTE: Not more than 4 corners, all in the same town and range, may be recorded on this certificate.

A. Description of original monument and accessories and/or subsequent restoration:

G-5	1831	G.L.O. Notes	Mullett	Set Post	P.A. 345 1990 KENT COUNTY
	1942-67	Witness Map	K.C. Surveyor	Stone & 3/4" Iron	PEER APPROVED <u>5/22/97</u>
	1976	L.C.R.C. #3268	C. Hay	3/4" Iron	CHAIRMAN <u>Hann Huber</u>
	1979	L.C.R.C. #3297	Glaza & Associates	Fnd. 3/4" Iron	
	1982	L.C.R.C. #3149	Moore & Bruggink	Fnd. 3/4" Iron Over Stone / Set K.C. Monument	
	1989	L.C.R.C. #5146	T. Chettleburgh	K.C. Monument	

This corner was originally approved by the Kent County Remonumentation Peer Group and monumented by Moore & Bruggink on 6/21/82 and was recorded per L.C.R.C. #3149.

B. Description of corner evidence found and/or method applied in restoring or reestablishing corner:

G-5 Found a Standard Kent County Monument at the C/L intersection of 2 Mile Road (gravel) running East and West and Cramton Road (gravel) running South per L.C.R.C.'s #3149 and #5146 as set by Moore & Bruggink in place of a 3/4" iron they found over stone which checked L.C.R.C.'s #3297, #3268 and the K.C. Surveyor's records.

L.C.R.C. #3149

L.C.R.C. #5146

- K.C. Nail & Tag 12" Oak S 40° W 65.86'
- K.C. Nail & Tag 12" Oak N 10° E 41.74'
- K.C. Nail & Tag 12" Oak N 60° E 59.00'
- K.C. Nail & Tag 15" Oak S 70° E 71.62'
- K.C. Nail & Tag 10" Oak S 45° E 56.68'


- K.C. Remon. Tag & Nail West side 12" Oak N 17° E 41.74' (m. 41.78')
- K.C. Remon. Tag & Nail Northwest side 10" Oak N 60° E 59.04' (m. 59.08')
- K.C. Remon. Tag & Nail Southwest side 18" Oak S 63° E 71.64'
- K.C. Remon. Tag & Nail Southwest side 10" Oak S 44° E 56.73'
- K.C. Remon. Tag & Nail Northwest side 11" Oak S 34° W 65.84'
- K.C. Remon. Tag & Nail West side Power Pole N 18° W 31.24'

The selected location is accepted by me and is generally accepted by professional surveyors as the best available evidence of the position of the original corner.

C. Description of monument for corner and accessories established to perpetuate locating the position of the corner:

G-5 Standard Kent County Monument

- Nail & K.C. remon. tag on W side 12" Oak N 17° E 41.78'
- Nail & K.C. remon. tag on NW side 10" Oak N 60° E 59.08'
- Nail & K.C. remon. tag on SW side 18" Oak S 63° E 71.64'
- Nail & K.C. remon. tag on SW side 10" Oak S 44° E 56.73'
- Nail & K.C. remon. tag on NW side 12" Oak S 34° W 65.84'
- Nail & K.C. remon. tag on W side P. pole N 18° W 31.24'

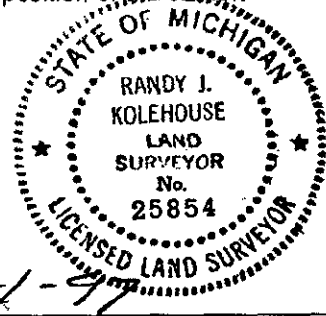

Signed by *Randy J. Kolehouse* Date 8-1-97

EARTH TECH

Surveyor's Michigan License No. 25854