

MAR 03 1998

SECTION

LAND CORNER RECORDATION CERTIFICATE
Filing Requirement of Act 74, Mich. P.A. 1970
KENT COUNTY REMONUMENTATION

REG. OF DEEDS
Lucy Sand
 97 OCT 15 AM 8:51
 STATE OF MICHIGAN
 COUNTY OF KENT
 RECEIVED FOR RECORD

For corners in


Kent (County)	Located in:	Ada Township	Corner Code #
1. Public Land Survey	T <u>7N</u>	R <u>10W</u>	<u>G-7</u>
	T _____	R _____	_____
	T _____	R _____	_____
	T _____	R _____	_____
2. Property Controlling in Section	S _____	T _____	R _____
	S _____	T _____	R _____
3. Miscellaneous Property in Sec.	S _____	T _____	R _____
	S _____	T _____	R _____

10206

Register of Deeds Stamp & File Number

4. Lot No. _____, Recorded Plat _____
 5. Private Claims _____

I, Randy Kolehouse, in a field survey on January 29 19 97, do hereby certify that under requirements of P.A. 74 Michigan P.A. of 1970, the corner points mentioned in lines 1 and 2 above were in conformance with regulations and rules therefore as required in the current manual of survey instructions of the United States Department of the Interior, Bureau of Land Management or by a decree of a Court of Law and/or that the corner points mentioned in lines 3, 4 and 5 above were in conformance with the rules of the Michigan Board of Land Surveyors or by a Decree of a Court of Law; established, re-established, monumented, re-monumented, recovered, found as expressed below:

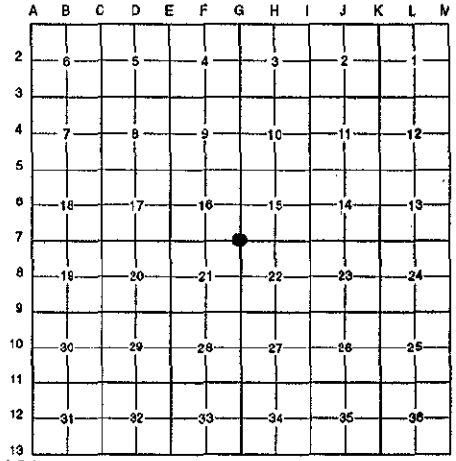

NOTE: Not more than 4 corners, all in the same town and range, may be recorded on this certificate.

A. Description of original monument and accessories and/or subsequent restoration:

G-7	1831	G.L.O. Notes	Mullett	Set Post	P.A. 345 1990 KENT COUNTY
	1957	Witness Map	K.C. Surveyor	N/A	PEER APPROVED <u>5/22/97</u>
	1972	L.C.R.C. #393	Williams & Works	3/4" Iron	CHAIRMAN <u>Randy Kolehouse</u>
	1981	L.C.R.C. #2505	C. Hay	Fnd. 1/2" Rerod and Cap / Set K.C. Monument	
	1982	L.C.R.C. #3284	C. Hay	Reset K.C. Monument (Due to Error on L.C.R.C. #2505)	
	1989	L.C.R.C. #5148	T. Chettleburgh	K.C. Monument	

This corner was originally approved by the Kent County Remonumentation Peer Group and monumented by C. Hay on 12/11/81 and recorded per L.C.R.C. #2505. Corrected in L.C.R.C. #3284 on 4/1/82 due to an error in the original certificate.

B. Description of corner evidence found and/or method applied in restoring or reestablishing corner:

G-7 Found a Standard Kent County Monument 8' West of the C/L of Cramton Avenue (gravel) running North and South and 10' North of the C/L of Leonard Street (gravel) running East on line of woods running West per L.C.R.C.'s #3284 and #5148 as set by C. Hay.

L.C.R.C. #3284

L.C.R.C. #5148


Nail and Tag in North Side 24" Maple, S 67° E 89.20'	K.C. Remon. Tag & Nail North side 26" Maple S 65° E 89.18'
Nail and Tag in South Side 26" Oak, N 62° W 38.02'	K.C. Remon. Tag & Nail Southwest side 22" Maple S 55° E 60.53' (m. 60.60')
Nail and Tag in NW Side 22" Oak S 40° W, 57.90'	K.C. Remon. Tag & Nail Northwest side 23" Oak S 40° W 57.78' (m. 57.70')
Nail and Tag in SE Side 14" Oak, S 72° W, 47.50'	K.C. Remon. Tag & Nail Southeast side 20" Oak S 73° W 47.51'
Nail and Tag in SW Side 18" Maple, S 54° E, 60.60'	K.C. Remon. Tag & Nail South side 38" Oak N 58° W 38.18'

The selected location is accepted by me and is generally accepted by professional surveyors as the best available evidence of the position of the original corner.

C. Description of monument for corner and accessories established to perpetuate locating the position of the corner:

G-7 Standard Kent County Monument

- Nail & K.C. remon. tag on N side 26" Maple S 65° E 89.18'
- Nail & K.C. remon. tag on SW side 22" Maple S 55° E 60.60'
- Nail & K.C. remon. tag on NW side 24" Oak S 40° W 57.70'
- Nail & K.C. remon. tag on SE side 20" Oak S 73° W 47.51'
- Nail & K.C. remon. tag on S side 38" Oak N 58° W 38.18'

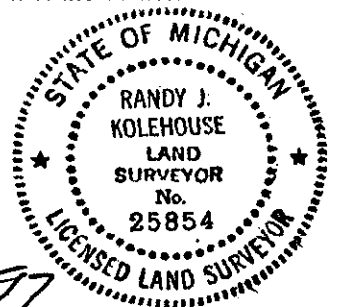

Signed by Randy J. Kolehouse Date 8-1-97

Surveyor's Michigan License No. 25854