

**SURVEY & REMONUMENTATIO**

MAR 03 1998

\$7.00  
\$2.00

**SECTION**

**LAND CORNER RECORDATION CERTIFICATE**  
Filing Requirement of Act 74, Mich. P.A. 1970  
KENT COUNTY REMONUMENTATION

For corners in

<u>Kent</u> (County)	Located in:	Ada Township	Corner Code #
1. Public Land Survey	T <u>7N</u>	R <u>10W</u>	<u>G-9</u>
	T _____	R _____	_____
	T _____	R _____	_____
	T _____	R _____	_____
2. Property Controlling in Section	S _____	T _____	R _____
	S _____	T _____	R _____
3. Miscellaneous Property in Sec.	S _____	T _____	R _____
	S _____	T _____	R _____
4. Lot No. _____, Recorded Plat _____			
5. Private Claims _____			

STATE OF MICHIGAN  
COUNTY OF KENT  
RECEIVED FOR RECORD  
97 NOV 14 AM 9:01  
REG. OF DEEDS  
*Lucy Bond*

10312

Register of Deeds Stamp & File Number

I, Randy Kolehouse, in a field survey on July 28 19 97, do hereby certify that under requirements of P.A. 74 Michigan P.A. of 1970, the corner points mentioned in lines 1 and 2 above were in conformance with regulations and rules therefore as required in the current manual of survey instructions of the United States Department of the interior, Bureau of Land Management or by a decree of a Court of Law and/or that the corner points mentioned in lines 3, 4 and 5 above were in conformance with the rules of the Michigan Board of Land Surveyors or by a Decree of a Court of Law; established, re-established, monumented, re-monumented, recovered, found as expressed below:

**NOTE: Not more than 4 corners, all in the same town and range, may be recorded on this certificate.**

A. Description of original monument and accessories and/or subsequent restoration:

G-9	1831	G.L.O. Notes	Mullett	Set Post
	1944	Witness Map	K.C. Surveyor	Iron
	1971	L.C.R.C. #18	J. Spencer	3/4" Pipe
	1980	L.C.R.C. #1494	Williams & Works	Fnd. 3/4" Iron / Set K.C. Monument
	1989	L.C.R.C. #5150	T. Chettleburgh	K.C. Monument

This corner was originally approved by the Kent County Remonumentation Peer Group and monumented by Williams & Works on 12/4/80 and was recorded per L.C.R.C. #1494.

B. Description of corner evidence found and/or method applied in restoring or reestablishing corner:

G-9 Found a Standard Kent County Monument in a circle of stones next to a steel fence post on line of a fence line running North and 20' ± South of the remains of a fence line running East and West per L.C.R.C.'s #1494 and #5150 as set by Williams & Works in place of a 3/4" iron they found in a circle of stones which checked L.C.R.C. #18 and the K.C. Surveyor's records.

L.C.R.C. #1494

- Nail & K.C. Remon. Tag East Side 16" Oak N 15°E 18.99'
- Nail & K.C. Remon. Tag NW'ly Side 16" Oak N 75°E 45.51'
- Nail & K.C. Remon. Tag E'ly Side 12" Oak S 12°E 35.61'
- Nail & K.C. Remon. Tag E'ly Side Triple 8" Poplar S 10°W 29.34'
- Nail & K.C. Remon. Tag E'ly Side 8" Oak S 45°W 46.97'
- Nail & K.C. Remon. Tag N'ly Side 26" Oak N 75°W 25.99'

L.C.R.C. #5150

- K. C. Remon. Tag & Nail East side 19" Oak N 10° E 18.97'
- K. C. Remon. Tag & Nail Northwest side 18" Oak N 75° W 45.51'
- K. C. Remon. Tag & Nail East side 15" Oak S 14° E 35.61' (m. 35.63')
- K. C. Remon. Tag & Nail East side Tri 9" Poplar S 12° W 29.84' (m. 29.88')
- K. C. Remon. Tag & Nail East side 10" Oak S 49° W 46.97'
- K. C. Remon. Tag & Nail in North side 26" Oak N 75° W 46.97'

The selected location is accepted by me and is generally accepted by professional surveyors as the best available evidence of the position of the original corner.

C. Description of monument for corner and accessories established to perpetuate locating the position of the corner:


G-9 Standard Kent County Monument

- Nail & K.C. remon. tag on E side 20" Oak N 10° E 18.97'
- Nail & K.C. remon. tag on NW side 20" Oak N 75° E 45.51'
- Nail & K.C. remon. tag on E side 18" Oak S 14° E 35.63'
- Nail & K.C. remon. tag on E side Tri 12" Poplar S 12° W 29.88'
- Nail & K.C. remon. tag on N side 28" Oak N 75° W 25.85'

P.A. 345 1990 KENT COUNTY.

PEER APPROVED 7/24/97

CHAIRMAN *Randy Kolehouse*

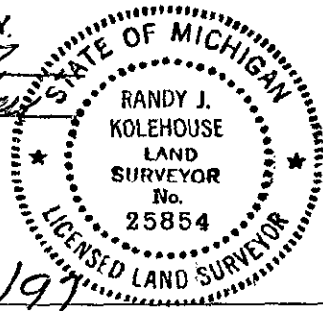

Signed by *Randy J. Kolehouse*

Date 9/23/97

Surveyor's Michigan License No. 25854