

FEB 14 1997

KENT COUNTY REMONUMENTATION

LAND CORNER RECORDATION CERTIFICATE
Filing Requirement of Act 74, Mich. P.A. 1970

For corners in
KENT COUNTY
(County)

Located In:	Corner Code #
1. Public Land Survey T7N R10W	G-13
T R	
T R	
T R	
2. Property Controlling in Section S T R	
S T R	
3. Miscellaneous Property in Sec. S T R	
S T R	

STATE OF MICHIGAN
 COUNTY OF KENT
 RECEIVED FOR RECORD
 96 SEP 13 PM 12:03
 REG. OF DEEDS
Lucy J. Bond

9341

Register of Deeds Stamp & File Number

4. Lot No. _____, Recorded Plat _____
 5. Private Claims _____

	A	B	C	D	E	F	G	H	I	J	K	L	M
1													
2	6		5		4		3		2		1		
3													
4	7		8		9		10		11		12		
5													
6	18		17		16		15		14		13		
7													
8	19		20		21		22		23		24		
9													
10	30		29		28		27		26		25		
11													
12	31		32		33		34		35		36		
13													

I, Kirk Breitels, in a field survey on June 13, 1996 do hereby state that under requirements of P.A. 74, Michigan P.A. of 1970, the corner points mentioned in lines 1 and 2 above were in conformance with regulations and rules therefore as required in the current manual of survey instructions of the United States Department of the Interior, Bureau of Land Management or by a decree of a Court of Law and for that the corner points mentioned in lines 3, 4 and 5 above were in conformance with the rules of the Michigan Board of Land Surveyors or by a Decree of a Court of Law; established, re-established, monumented, recovered, found as expressed below:

NOTE: Not more than 2 corners, all in the same town and range, may be recorded on this certificate.

A. Description of original monument and accessories and/or subsequent restoration:

G-13	1831	GLO	Mullett	Set Post
	1960	Kent Co. Wit.		Iron
	1978	LCRC #1215	Bonnema	Iron
	1981	LCRC #1769	Merdzinski	Set Kent County Monument
	1989	LCRC #5153	Chettleburgh	Kent County Monument

P.A. 345 1990 KENT COUNTY

PEER APPROVED 8/22/96
 CHAIRMAN *Harry Huber*

The position of this corner was previously approved by the Kent County Remonumentation Peer Group, monumented by John A. Merdzinski on 1/30/81 and was recorded per LCRC #1769

B. Description of corner evidence found and/or method applied in restoring or reestablishing corner:

G-13 Found standard Kent Co. Mon. (Harrison) per witnesses from above LCRC as set by John A. Merdzinski in place of the 3/4" Iron Pipe he found. Said Iron Pipe checks with LCRC #1215. No Kent Co. Wit. remained.

LCRC #1769 (Nail/tag in trees)

14" Pine S50°E 29.34' 22" Oak S35°W 69.23'
 10" Pine S00°E 18.61' 8" Elm N10°E 49.45'
 12" Pine S55°W 30.54'
 10" Pine N90°W 3.55'
 5.55' N. of N. edge blktp. dr.

LCRC #5153 (Nail/tag in trees)


15" Pine S50°E 29.33' 11" Elm N11°E 49.56'
 11" Pine S02°W 18.56' 23" Oak S34°W 66.18'
 10" Pine S55°W 30.50'
 12" Pine N90°W 3.50'
 G-1, T6N, R10W West 59.34'

The selected location is accepted by me and is generally accepted by professional surveyors as the best available evidence of the position of the original corner.

C. Description of monument for corner and accessories established to perpetuate locating the position of the corner:

G-13 Standard Kent County Monument

New Nail & KC Remon. tag E. side	15" Elm	N11°E	49.58'
Nail & KC Remon. tag N. side	18" Pine	S50°E	29.35'
Nail & KC Remon. tag E. side	14" Pine	S02°W	18.58'
Nail & KC Remon. tag E. side	27" Oak	S34°W	66.23'
Nail & KC Remon. tag NW side	12" Pine	S55°W	30.54'
Nail & KC Remon. tag N. side	12" Pine	N90°W	3.50'
Kent Co. Mon. (G-1, T6N, R10W)	West		59.31'
N. edge bit. drive is S.			5.55'
C/L Thornapple River Dr. is E.			75'±

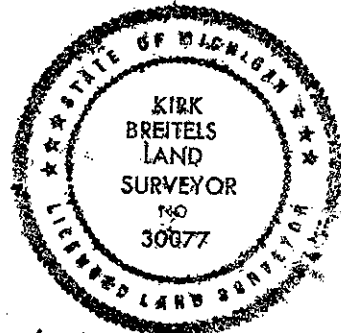

Signed by *Kirk Breitels*

Date 8/25/96

Surveyor's Michigan License No. 30077