

# SURVEY & REMONUMENTATION

MAR 03 1998

## LAND CORNER RECORDATION CERTIFICATE Filing Requirement of Act 74, Mich. P.A. 1970 KENT COUNTY REMONUMENTATION

For corners in SECTION


<u>Kent</u> (County)	Located in: <u>Ada</u> Township	Corner Code # <u>H-1</u>
1. Public Land Survey	T <u>7N</u> R <u>10W</u>	<u>H-1</u>
	T _____ R _____	_____
	T _____ R _____	_____
	T _____ R _____	_____
2. Property Controlling in Section	S _____ T _____ R _____	_____
	S _____ T _____ R _____	_____
3. Miscellaneous Property in Sec.	S _____ T _____ R _____	_____
	S _____ T _____ R _____	_____
4. Lot No. _____, Recorded Plat _____		
5. Private Claims _____		

STATE OF MICHIGAN  
 COUNTY OF KENT  
 RECEIVED FOR RECORD  
 97 OCT 15 AM 8:51  
 REG. OF DEEDS  
*Luci Sand*

**10209**

Register of Deeds Stamp & File Number

I, Randy Kolehouse, in a field survey on June 5 19 97, do hereby certify that under requirements of P.A. 74 Michigan P.A. of 1970, the corner points mentioned in lines 1 and 2 above were in conformance with regulations and rules therefore as required in the current manual of survey instructions of the United States Department of the interior, Bureau of Land Management or by a decree of a Court of Law and/or that the corner points mentioned in lines 3, 4 and 5 above were in conformance with the rules of the Michigan Board of Land Surveyors or by a Decree of a Court of Law; established, re-established, monumented, re-monumented, recovered, found as expressed below:

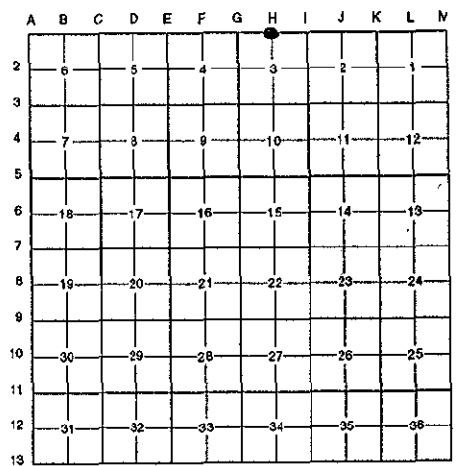

**NOTE: Not more than 4 corners, all in the same town and range, may be recorded on this certificate.**

**A. Description of original monument and accessories and/or subsequent restoration:**

H-1 This corner was not originally set by the G.L.O.

1960	Witness Map	K.C. Surveyor	"T" Iron
1984	L.C.R.C. #3956	Exxel Engineering	Fnd. "T" Iron / Set K.C. Monument
1989	L.C.R.C. #5240	J. Bueche	K.C. Monument

Note: This corner is not common with H-13, T8N, R10W.

This corner was originally approved by the Kent County Remonumentation Peer Group and monumented by Exxel Engineering on 9/7/84 and was recorded per L.C.R.C. #3956.

P.A. 345 1990 KENT COUNTY  
 PEER APPROVED 6/26/97  
*Harry Huber*  
 CHAIRMAN

**B. Description of corner evidence found and/or method applied in restoring or reestablishing corner:**

H-1 Found a Standard Kent County Monument on the Township line (1.5' below grade) 3' ± North of the C/L of 4 Mile Road (gravel) running East and West per L.C.R.C.'s #3956 and #5240 as set by Exxel Engineering in place of a "T" iron they found 0.61' North of the Township Line which checked the K.C. Surveyor's records.

L.C.R.C. #3956

L.C.R.C. #5240

Nail & remon tag in SE sde 10" Walnut N 47° E 37.86'  
 Nail & remon tag in S sde 15" Walnut N 58° W 46.78'  
 Nail & remon tag in N sde 8" Walnut N 04° E 27.68'  
 Nail & remon tag in W sde 8" Walnut S 20° W 41.35'  
 Nail & remon tag in SE sde 10" Walnut S 65° W 67.38'  
 S 1/4 corner Section 34, T8N, R10W (C.I. Mon.) East 220.98'

Nail & remon. tag in SE side 12" Walnut N 47° E 37.86' (m. 37.87')  
 Nail & remon. tag in S side 16" Walnut N 58° W 46.78'  
 Nail & remon. tag in W side 10" Walnut N 04° E 27.68' (m. 27.70')  
 Nail & remon. tag in W side 10" Walnut S 20° W 41.35'  
 Nail & remon. tag in SE side 14" Walnut S 65° W 67.62'  
 S 1/4 cor. Section 34, T8N, R10W (C.I. Mon.) East 220.98'

The selected location is accepted by me and is generally accepted by professional surveyors as the best available evidence of the position of the original corner.

**C. Description of monument for corner and accessories established to perpetuate locating the position of the corner:**

H-1 Standard Kent County Monument

Nail & K.C. remon. tag on SE side 12" Walnut N 47° E 37.87'  
 Nail & K.C. remon. tag on S side 16" Walnut N 58° W 46.78'  
 Nail & K.C. remon. tag on W side 10" Walnut N 04° E 27.70'  
 Nail & K.C. remon. tag on W side 10" Walnut S 20° W 41.35'  
 Nail & K.C. remon. tag on SE side 14" Walnut N 65° W 67.62'  
 K.C. Mon. S 1/4 Sec. 34, T8N, R10W, East 220.98'



Signed by *Randy J. Kolehouse* Date 6-1-97  
EARTH TECH

Surveyor's Michigan License No. 25854