

SURVEY & REMONUMENTATION

\$7.00
\$2.00

MAR 03 1998

LAND CORNER RECORDATION CERTIFICATE
Filing Requirement of Act 74, Mich. P.A. 1970
KENT COUNTY REMONUMENTATION

STATE OF MICHIGAN
COUNTY OF KENT
RECEIVED FOR RECORD
97 DEC 15 AM 10:42
REG. OF DEEDS
Lucy St. Grand

For corners in

SECTION


Kent (County)	Located in: Township	Ada Township	Corner Code #
1. Public Land Survey	T <u>7N</u>	R <u>10W</u>	<u>H-2</u>
	T _____	R _____	_____
	T _____	R _____	_____
	T _____	R _____	_____
2. Property Controlling in Section	S _____	T _____	R _____
	S _____	T _____	R _____
3. Miscellaneous	S _____	T _____	R _____
Property in Sec.	S _____	T _____	R _____

10365

Register of Deeds Stamp & File Number

4. Lot No. _____, Recorded Plat _____
5. Private Claims _____

I, Randy Kolehouse, in a field survey on October 7 19 97, do hereby certify that under requirements of P.A. 74 Michigan P.A. of 1970, the corner points mentioned in lines 1 and 2 above were in conformance with regulations and rules therefore as required in the current manual of survey instructions of the United States Department of the interior, Bureau of Land Management or by a decree of a Court of Law and/or that the corner points mentioned in lines 3, 4 and 5 above were in conformance with the rules of the Michigan Board of Land Surveyors or by a Decree of a Court of Law; established, re-established, monumented, re-monumented, recovered, found as expressed below:

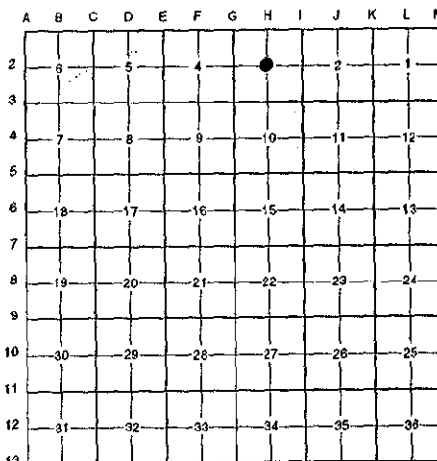

NOTE: Not more than 4 corners, all in the same town and range, may be recorded on this certificate.

A. Description of original monument and accessories and/or subsequent restoration:

- 1-2 This corner was not originally set by the G.L.O.
1956 Witness Map K.C. Surveyor "City Iron"

P.A. 345 1990 KENT COUNTY
PEER APPROVED 10/16/97
CHAIRMAN [Signature]

Description of corner evidence found and/or method applied in restoring or reestablishing corner:


- 2 The Kent County Surveyor's witness map shows a "City iron" at this corner. Did not find iron or witnesses. Presume "City iron" is shown incorrectly. Decided to hold intersection of 1/4 lines. Found remnants of fence 10' East and 25' South.

The selected location is accepted by me and is generally accepted by professional surveyors as the best available evidence of the position of the original corner.

Description of monument for corner and accessories established to perpetuate locating the position of the corner:

- 2 Set a Standard Kent County Monument @ Intersection of 1/4 Lines

- Nail & K.C. remon. tag on E side 6" Elm N 00° E 20.61'
- Nail & K.C. remon. tag on SE side 20" Elm N 60° E 16.55'
- Nail & K.C. remon. tag on NW side 8" Elm S 45° W 5.07'
- Nail & K.C. remon. tag on N side 24" Elm N 90° W 43.54'
- Old fence line running North and South 10' ± East
- Old fence line running East and West 25' ± South

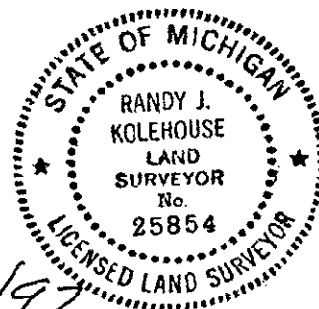

Recorded by Randy J. Kolehouse Date 12/5/97

Surveyor's Michigan License No. 25854