

**SURVEY & REMONUMENTATION**

MAR 03 1998

**LAND CORNER RECORDATION CERTIFICATE**  
**Filing Requirement of Act 74, Mich. P.A. 1970**  
**KENT COUNTY REMONUMENTATION**

For corners in Kent SECTION \_\_\_\_\_  
 (County)

Located in: Ada Corner Code #  
 Township

1. Public Land Survey	T <u>7N</u>	R <u>10W</u>	<u>H-3</u>
	T _____	R _____	_____
	T _____	R _____	_____
	T _____	R _____	_____
2. Property Controlling in Section	S _____	T _____	R _____
	S _____	T _____	R _____
3. Miscellaneous Property in Sec.	S _____	T _____	R _____
	S _____	T _____	R _____

4. Lot No. \_\_\_\_\_, Recorded Plat \_\_\_\_\_  
 5. Private Claims \_\_\_\_\_

STATE OF MICHIGAN  
 COUNTY OF KENT  
 RECEIVED FOR RECORD


97 OCT 15 AM 8:51

REG. OF DEEDS  
*Luci Standa*

**10210**

Register of Deeds Stamp & File Number

I, Randy Kolehouse, in a field survey on April 11 19 97, do hereby certify that under requirements of P.A. 74 Michigan P.A. of 1970, the corner points mentioned in lines 1 and 2 above were in conformance with regulations and rules therefore as required in the current manual of survey instructions of the United States Department of the interior, Bureau of Land Management or by a decree of a Court of Law and/or that the corner points mentioned in lines 3, 4 and 5 above were in conformance with the rules of the Michigan Board of Land Surveyors or by a Decree of a Court of Law; established, re-established, monumented, re-monumented, recovered, found as expressed below:

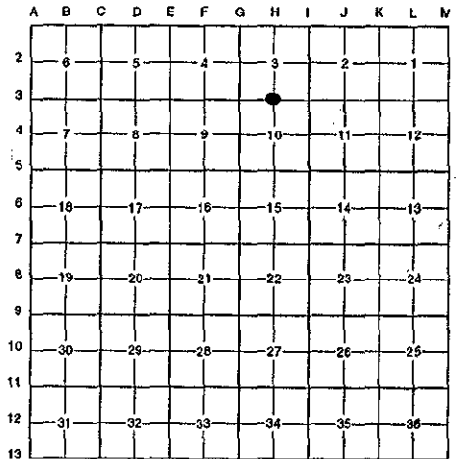

**NOTE: Not more than 4 corners, all in the same town and range, may be recorded on this certificate.**

**A. Description of original monument and accessories and/or subsequent restoration:**

H-3	1831	G.L.O. Notes	Mullett	Set Post
	1949	Witness Map	K.C. Surveyor	Stake & Stone
	1981	L.C.R.C. #2498	Williams & Works	Capped Rebar
	1982	L.C.R.C. #3150	Moore & Bruggink	Fnd. Capped Iron / Set K.C. Monument
	1994	L.C.R.C. #8060	Glaza & Associates	K.C. Monument

P.A. 345 1990 KENT COUNTY  
 PEER APPROVED 5/22/97  
 CHAIRMAN *Stan Stuber*  
 Monumented by Moore & Bruggink

This corner was originally approved by the Kent County Remonumentation Peer Group and Monumented by Moore & Bruggink on 6/18/82 and was recorded per L.C.R.C. #3150.

**B. Description of corner evidence found and/or method applied in restoring or reestablishing corner:**

H-3 Found a Standard Kent County Monument 10' North of the C/L of 3 Mile Road (gravel) running East and West on line of a fence line running South per L.C.R.C.'s #3150 and #8060 as set by Moore & Bruggink in place of a capped iron they found over a 2-1/2" iron which checked L.C.R.C. #2498 and the K.C. Surveyor's records.

L.C.R.C. #3150

L.C.R.C. #8060

- K.C. Nail & Tag 8" Hickory N 30° W 48.75'
- K.C. Nail & Tag 20" Oak North 42.18'
- K.C. Nail & Tag 20" Oak N 60° E 17.96'
- K.C. Nail & Tag 15" Oak S 70° E 89.43'
- K.C. Nail & Tag 15" Oak S 60° W 63.36'


- K.C. remon tag & nail in SW side 10" Hickory N 30° W 48.75'
- K.C. remon tag & nail in W side 20" Oak North 41.75'
- K.C. remon tag & nail in SE side 22" Oak N 60° E 17.89'
- K.C. remon tag & nail in N side 20" Oak S 70° E 89.49'
- K.C. remon tag & nail in NW side 20" Oak S 60° W 64.01'
- C/L East-West gravel road 10' South S 60° W 64.01'

The selected location is accepted by me and is generally accepted by professional surveyors as the best available evidence of the position of the original corner.

**C. Description of monument for corner and accessories established to perpetuate locating the position of the corner:**

H-3 Standard Kent County Monument

- Nail & K.C. remon. tag on SW side 10" Hickory N 30° W 48.75'
- Nail & K.C. remon. tag on W side 20" Oak North 41.75'
- Nail & K.C. remon. tag on SE side 22" Oak N 60° E 17.89'
- Nail & K.C. remon. tag on N side 20" Oak S 70° E 89.49'
- Nail & K.C. remon. tag on NW side 20" Oak S 60° W 64.01'
- C/L E/W gravel rd. South 10'

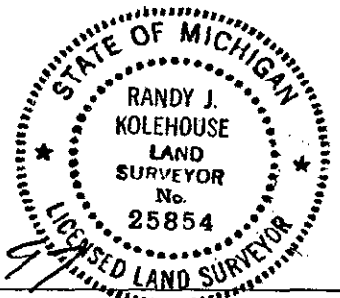

Signed by Randy J. Kolehouse Date 8-1-97  
 EARTH TECH

Surveyor's Michigan License No. 25854