

SURVEY & REMONUMENTATION

\$7.00
\$2.00 **MAR 03 1998**

LAND CORNER RECORDATION CERTIFICATE
Filing Requirement of Act 74, Mich. P.A. 1970
KENT COUNTY REMONUMENTATION

REG. OF DEEDS
Lucy Bond
97 DEC 15 AM 10:42
STATE OF MICHIGAN
COUNTY OF KENT
RECEIVED FOR RECORD

SECTION


For corners in

Kent (County)	Located in:	Ada Township	Corner Code #
1. Public Land Survey	T <u>7N</u>	R <u>10W</u>	<u>H-4</u>
	T _____	R _____	_____
	T _____	R _____	_____
	T _____	R _____	_____
2. Property Controlling in Section	S _____	T _____	R _____
	S _____	T _____	R _____
3. Miscellaneous Property in Sec.	S _____	T _____	R _____
	S _____	T _____	R _____

10366

Register of Deeds Stamp & File Number

4. Lot No. _____, Recorded Plat _____
5. Private Claims _____

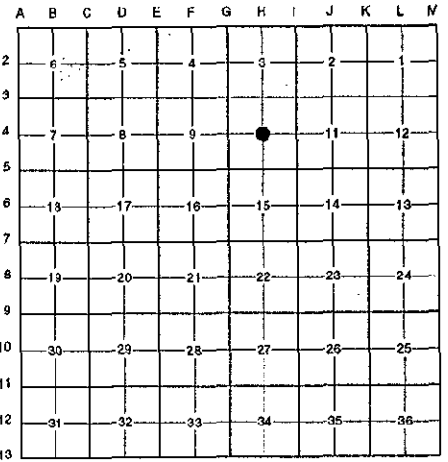

I, Randy Kolehouse, in a field survey on October 1 19 97, do hereby certify that under requirements of P.A. 74 Michigan P.A. of 1970, the corner points mentioned in lines 1 and 2 above were in conformance with regulations and rules therefore as required in the current manual of survey instructions of the United States Department of the interior, Bureau of Land Management or by a decree of a Court of Law and/or that the corner points mentioned in lines 3, 4 and 5 above were in conformance with the rules of the Michigan Board of Land Surveyors or by a Decree of a Court of Law; established, re-established, monumented, re-monumented, recovered, found as expressed below:

NOTE: Not more than 4 corners, all in the same town and range, may be recorded on this certificate.

A. Description of original monument and accessories and/or subsequent restoration:

H-4 This corner was not originally set by the G.L.O.
1979 L.C.R.C. #1393 Moore & Bruggink Fnd. 2" Pipe @ Int. of 1/4 Lines

P.A. 345 1990 KENT COUNTY
PEER APPROVED 10/16/97
CHAIRMAN Harry Huber

B. Description of corner evidence found and/or method applied in restoring or reestablishing corner:

H-4 Found a 2" iron pipe on line of a tree line running North (per L.C.R.C. #1393), 25' ± West and 15' ± South of a new garage, and approximately 300' ± South of Knapp Street. Iron pipe is 0.2' North and 1.5' West of the intersection of 1/4 lines. Accepted iron pipe as Center of Section.


L.C.R.C. #1393

PK in E side 18" Box Elder North 8.23' (m. 8.37')
Knapp Street North 300' ±

The selected location is accepted by me and is generally accepted by professional surveyors as the best available evidence of the position of the original corner.

C. Description of monument for corner and accessories established to perpetuate locating the position of the corner:

H-4 Replaced 2" Iron Pipe with a Standard Kent County Monument
Nail & K.C. remon. tag on W side 28" Box Elder N 00° E 8.37'
Nail & K.C. remon. tag on E side 18" Maple S 20° W 25.78'
Nail & K.C. remon. tag on S side 6" Pine N 90° W 28.08'
SW corner 2-story garage N 80° E 22.69'

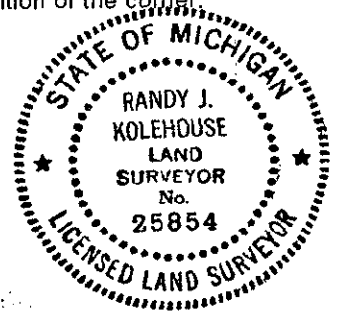

Signed by Randy J. Kolehouse
EARTH TECH

Date 12/5/97

Surveyor's Michigan License No. 25854