

SURVEY & REMONUMENTATION

\$7.00
\$2.00

MAR 08 1998

LAND CORNER RECORDATION CERTIFICATE
Filing Requirement of Act 74, Mich. P.A. 1970
KENT COUNTY REMONUMENTATION

For corners in


SECTION

Kent (County)	Located in:	Ada Township	Corner Code #
1. Public Land Survey	T <u>7N</u>	R <u>10W</u>	<u>H-6</u>
	T _____	R _____	_____
	T _____	R _____	_____
	T _____	R _____	_____
2. Property Controlling in Section	S _____	T _____	R _____
	S _____	T _____	R _____
3. Miscellaneous Property in Sec.	S _____	T _____	R _____
	S _____	T _____	R _____

STATE OF MICHIGAN
COUNTY OF KENT
RECEIVED FOR RECORD
97 DEC 15 AM 10:42
REG. OF DEEDS
Lucy St. Paul
10367
Register of Deeds Stamp & File Number

4. Lot No. _____, Recorded Plat _____
5. Private Claims _____

I, Randy Kolehouse, in a field survey on August 5 19 97, do hereby certify that under requirements of P.A. 74 Michigan P.A. of 1970, the corner points mentioned in lines 1 and 2 above were in conformance with regulations and rules therefore as required in the current manual of survey instructions of the United States Department of the Interior, Bureau of Land Management or by a decree of a Court of Law and/or that the corner points mentioned in lines 3, 4 and 5 above were in conformance with the rules of the Michigan Board of Land Surveyors or by a Decree of a Court of Law; established, re-established, monumented, re-monumented, recovered, found as expressed below:

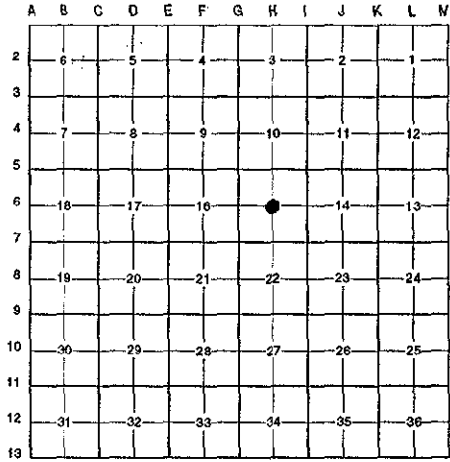

NOTE: Not more than 4 corners, all in the same town and range, may be recorded on this certificate.

A. Description of original monument and accessories and/or subsequent restoration:

H-6 This corner was not originally set by the G.L.O.
1966 Survey Notes Williams & Works Set "T" Iron @ the Intersection of 1/4 Lines
1974 L.C.R.C. #864 Medema, Van Kooten & Assoc. "T" Iron

B. Description of corner evidence found and/or method applied in restoring or reestablishing corner:

H-6 Found a "T" iron at the base of a high hill on the South edge of a swamp 7.3' East of the remains of a fence line running North and South and 5.0' South of the remains of a fence line running East and West per L.C.R.C.'s #864 as set at the intersection of 1/4 lines by Williams & Works in 1966. "T" iron is 2.0' North and 0.2' West of the intersection of 1/4 lines. Accepted "T" iron as Center of Section.

Williams & Works - 1966

L.C.R.C. #864

- 12" Maple SE 5.29'
- 18" Oak SSW 25.09'
- 12" Maple W 20.57'

- 12" Maple (nail in) SE 5.28'
- Nail in 20" Oak S-SW 25.00'
- Nail in 12" Maple W 20.56'
- Fence N 5.0'
- Fence W 7.0'

P.A. 345 1990 KENT COUNTY
PEER APPROVED 9/27/97
CHAIRMAN *Henry Huber*

The selected location is accepted by me and is generally accepted by professional surveyors as the best available evidence of the position of the original corner.

C. Description of monument for corner and accessories established to perpetuate locating the position of the corner:

- H-6 Replaced "T" Iron with a Standard Kent County Monument
- Nail & K.C. remon. tag on N side 12" Maple S 75° E 67.23'
 - Nail & K.C. remon. tag on N side 16" Maple S 55° E 5.85'
 - Nail & K.C. remon. tag on NW side 28" B. Oak S 51° W 31.68'
 - Nail & K.C. remon. tag on N side 6" Maple S 81° W 54.79'
 - Nail & K.C. remon. tag on N side 14" Maple N 79° W 21.35'
 - Nail & K.C. remon. tag on SW side 14" Ash N 35° W 31.77'
 - Fence running N-S, West 7' ±
 - Fence running E, North 5' ±



Signed by *Randy J. Kolehouse* Date 11/28/97
EARTH TECH

Surveyor's Michigan License No. 25854