

SURVEY & REMONUMENTATION

MAR 03 1998

LAND CORNER RECORDATION CERTIFICATE
Filing Requirement of Act 74, Mich. P.A. 1970
KENT COUNTY REMONUMENTATION

STATE OF MICHIGAN
 COUNTY OF KENT
 RECEIVED FOR RECORD
 97 OCT 15 AM 8:51
 REG. OF DEEDS
Eric J. Hand

SECTION

For corners in	Located in:	Corner Code #
<u>Kent</u> (County)	Ada Township	
1. Public Land Survey	T <u>7N</u> R <u>10W</u>	<u>H-7</u>
	T _____ R _____	_____
	T _____ R _____	_____
	T _____ R _____	_____
2. Property Controlling in Section	S _____ T _____ R _____	_____
	S _____ T _____ R _____	_____
3. Miscellaneous Property in Sec.	S _____ T _____ R _____	_____
	S _____ T _____ R _____	_____


10212

Register of Deeds Stamp & File Number

4. Lot No. _____, Recorded Plat _____
 5. Private Claims _____

I, Randy Kolehouse, in a field survey on June 3 19 97, do hereby certify that under requirements of P.A. 74 Michigan P.A. of 1970, the corner points mentioned in lines 1 and 2 above were in conformance with regulations and rules therefore as required in the current manual of survey instructions of the United States Department of the interior, Bureau of Land Management or by a decree of a Court of Law and/or that the corner points mentioned in lines 3, 4 and 5 above were in conformance with the rules of the Michigan Board of Land Surveyors or by a Decree of a Court of Law; established, re-established, monumented, re-monumented, recovered, found as expressed below:

NOTE: Not more than 4 corners, all in the same town and range, may be recorded on this certificate.

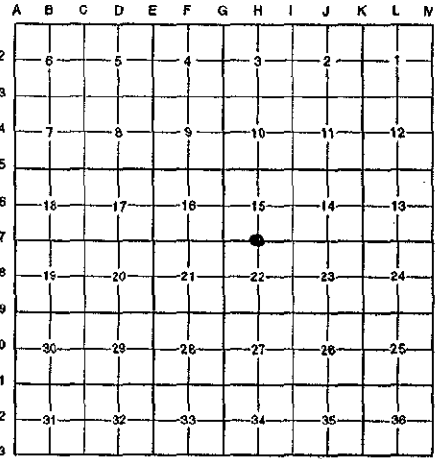

A. Description of original monument and accessories and/or subsequent restoration:

H-7	1831	G.L.O. Notes	Mullet	Set Post
	1957-	Witness Map	K.C. Surveyor	Iron
	1973	L.C.R.C. #581	Williams & Works	1" Iron
	1975	L.C.R.C. #796	Moore & Bruggink	Iron
	1981	L.C.R.C. #2507	C. Hay	Fnd. 3/4" Iron / Set K.C. Monument
	1995	L.C.R.C. #8062	Glaza & Associates	K.C. Monument

P.A. 345 1990 KENT COUNTY
 PEER APPROVED 6/26/97
 CHAIRMAN Randy Kolehouse

This corner was originally approved by the Kent County Remonumentation Peer Group and monumented by C. Hay on 12/11/81 and was recorded per L.C.R.C. #2507.

B. Description of corner evidence found and/or method applied in restoring or reestablishing corner:

H-7 Found a Standard Kent County Monument (.5' below grade) 5' South of the C/L of Leonard Street (gravel) running East and West and 5' West of the C/L of gravel drive to residence running Northwest per L.C.R.C.'s #2507 and #8062 as set by C. Hay in place of a 3/4" iron he found over a 1" iron 20" ± below ground which checked L.C.R.C.'s #796, #581 and the K.C. Surveyor's records.

L.C.R.C. #2507

- Remon tag in SE side 12" Walnut N 35° E 36.08'
- Remon tag in East side 16" Oak N 30° W 90.42'
- Remon tag in SE side 12" Oak S 50° W 36.75'
- Remon tag in SW side 12" Hickory S 20° E 33.93'
- Remon tag in West side of 8" Hickory (West Tree of a Twin) S 15° W 33.70'

L.C.R.C. #8062


- K.C. remon tag & nail in SE side 14" Walnut N 35° E 36.17'
- K.C. remon tag & nail in E side 24" Oak N 30° W 90.42'
- K.C. remon tag & nail in SE side 16" Oak S 50° W 36.75'
- K.C. remon tag & nail in SW side 12" Hickory S 20° E 33.87'
- K.C. remon tag & nail in W side 8" Hickory (W tree of twin) S 15° W 33.70'

The selected location is accepted by me and is generally accepted by professional surveyors as the best available evidence of the position of the original corner.

C. Description of monument for corner and accessories established to perpetuate locating the position of the corner:

H-7 Standard Kent County Monument

- Nail & K.C. remon. tag on SE side 14" Walnut N 35° E 36.17'
- Nail & K.C. remon. tag on E side 24" Oak N 30° W 90.42'
- Nail & K.C. remon. tag on SE side 16" Oak S 50° W 36.75'
- Nail & K.C. remon. tag on SW side 12" Hickory S 20° E 33.87'
- Nail & K.C. remon. tag on W side 8" Hickory S 15° W 33.70'

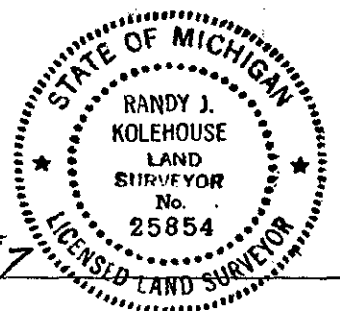

Signed by Randy J. Kolehouse
 EARTH TECH

Date 8-1-97

Surveyor's Michigan License No. 25854