

**SURVEY & REMONUMENTATION**

\$7.00  
\$2.00

MAR 03 1998

SECTION

**LAND CORNER RECORDATION CERTIFICATE**  
Filing Requirement of Act 74, Mich. P.A. 1970  
KENT COUNTY REMONUMENTATION

For corners in

Kent (County)	Located in: Ada Township	Corner Code #
1. Public Land Survey	T <u>7N</u> R <u>10W</u>	<u>I-3</u>
	T _____ R _____	_____
	T _____ R _____	_____
	T _____ R _____	_____
2. Property Controlling In Section	S _____ T _____ R _____	_____
	S _____ T _____ R _____	_____
3. Miscellaneous Property in Sec.	S _____ T _____ R _____	_____
	S _____ T _____ R _____	_____


STATE OF MICHIGAN  
COUNTY OF KENT  
RECEIVED FOR RECORD  
97 NOV 14 AM 9:01  
REG. OF DEEDS  
*David Standa*

**10315**

Register of Deeds Stamp & File Number

4. Lot No. \_\_\_\_\_, Recorded Plat \_\_\_\_\_  
5. Private Claims \_\_\_\_\_

I, Randy Kolehouse, in a field survey on August 8 19 97, do hereby certify that under requirements of P.A. 74 Michigan P.A. of 1970, the corner points mentioned in lines 1 and 2 above were in conformance with regulations and rules therefore as required in the current manual of survey instructions of the United States Department of the interior, Bureau of Land Management or by a decree of a Court of Law and/or that the corner points mentioned in lines 3, 4 and 5 above were in conformance with the rules of the Michigan Board of Land Surveyors or by a Decree of a Court of Law; established, re-established, monumented, re-monumented, recovered, found as expressed below:

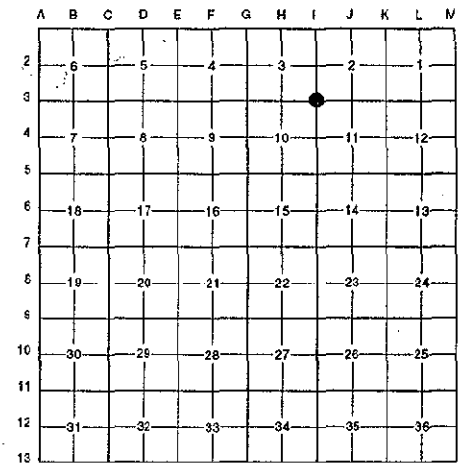

**NOTE: Not more than 4 corners, all in the same town and range, may be recorded on this certificate.**

A. Description of original monument and accessories and/or subsequent restoration:

I-3	1831	G.L.O. Notes	Mullett	Set Post
	1949	Witness Map	K.C. Surveyor	2-1/2" Iron
	1973	L.C.R.C. #531	Exxel Engineering	2-1/2" Iron
	1981	L.C.R.C. #2590	Jonker Land Surveys	Fnd. 2-1/2" Iron / Set K.C. Monument
	1995	L.C.R.C. #8068	Glaza & Associates	K.C. Monument

This corner was originally approved by the Kent County Remonumentation Peer Group and monumented by Rob Jonker on 12/21/81 and was recorded per L.C.R.C. #2590.

B. Description of corner evidence found and/or method applied in restoring or reestablishing corner:


I-3	Found a Standard Kent County Monument in a swamp 3' ± Northwest of the remains of a fence running East and West and 60' ± East of the edge of a group of Tamaracks per L.C.R.C.'s #2590 and #8068 as set by Rob Jonker in place of a 2-1/2" x 30" pinched pipe he found which checked L.C.R.C. #531 and the K.C. Surveyor's records.												
	<table border="0"> <tr> <td style="text-align: center;">L.C.R.C. #2590</td> <td style="text-align: center;">L.C.R.C. #8068</td> </tr> <tr> <td>Remon. tag on E side 8" Tamarack S14°W 20.37'</td> <td>K.C. remon tag &amp; nail in E side 8" Tamarack S14°W 20.37'</td> </tr> <tr> <td>Remon. tag on S side 6" Tamarack S88°W 18.45'</td> <td>K.C. remon tag &amp; nail in S side 10" Tamarack S88°W 18.45'</td> </tr> <tr> <td>Remon. tag on E side 5" Tamarack N09°W 3.78'</td> <td>K.C. remon tag &amp; nail in E side 8" Tamarack N09°W 3.78'</td> </tr> <tr> <td>Remon. tag on N side 7" Tamarack S66°E 17.45'</td> <td>K.C. remon tag &amp; nail in N side 8" Tamarack S66°E 17.68'</td> </tr> <tr> <td></td> <td>West edge of Tamarack group 60' West</td> </tr>

The selected location is accepted by me and is generally accepted by professional surveyors as the best available evidence of the position of the original corner.

C. Description of monument for corner and accessories established to perpetuate locating the position of the corner:

I-3	Standard Kent County Monument
	Nail & K.C. remon. tag on E side 8" Tamarack S 14° W 20.37'
	Nail & K.C. remon. tag on S side 10" Tamarack S 88° W 18.45'
	Nail & K.C. remon. tag on E side 8" Tamarack N 09° W 3.78'
	Nail & K.C. remon. tag on N side 8" Tamarack S 66° E 17.68'

Signed by *Randy J. Kolehouse* Date 9/23/97  
EARTH TECH

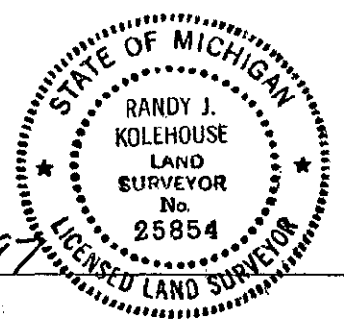

Surveyor's Michigan License No. 25854