

SURVEY & REMONUMENTATION

MAR 03 1998

SECTION

LAND CORNER RECORDATION CERTIFICATE
Filing Requirement of Act 74, Mich. P.A. 1970
KENT COUNTY REMONUMENTATION

For corners in


For corners in	Located in:	Corner Code #
<u>Kent</u> (County)	Ada Township	
1. Public Land Survey	T <u>7N</u> R <u>10W</u>	<u>I-4</u>
	T _____ R _____	_____
	T _____ R _____	_____
	T _____ R _____	_____
2. Property Controlling in Section	S _____ T _____ R _____	_____
	S _____ T _____ R _____	_____
3. Miscellaneous Property in Sec.	S _____ T _____ R _____	_____
	S _____ T _____ R _____	_____

STATE OF MICHIGAN
 COUNTY OF KENT
 RECEIVED FOR RECORD
 97 OCT 15 AM 8:51
 REG. OF DEEDS
W. J. Bond

10215
 Register of Deeds Stamp & File Number

4. Lot No. _____, Recorded Plat _____
 5. Private Claims _____

I, Randy Kolehouse, in a field survey on July 9 19 97, do hereby certify that under requirements of P.A. 74 Michigan P.A. of 1970, the corner points mentioned in lines 1 and 2 above were in conformance with regulations and rules therefore as required in the current manual of survey instructions of the United States Department of the interior, Bureau of Land Management or by a decree of a Court of Law and/or that the corner points mentioned in lines 3, 4 and 5 above were in conformance with the rules of the Michigan Board of Land Surveyors or by a Decree of a Court of Law; established, re-established, monumented, re-monumented, recovered, found as expressed below:

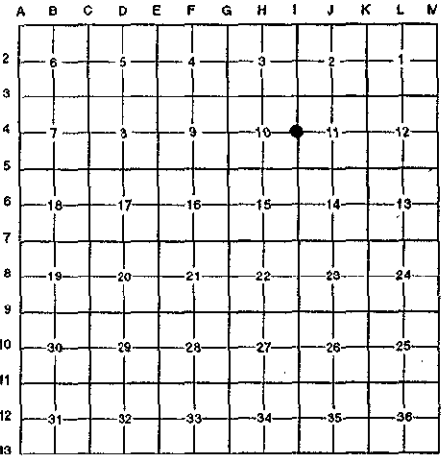

NOTE: Not more than 4 corners, all in the same town and range, may be recorded on this certificate.

A. Description of original monument and accessories and/or subsequent restoration:

I-4	Description	Surveyor	Monument
1831	G.L.O. Notes	Mullett	Set Post
1949	Witness Map	K.C. Surveyor	3/4" Iron
1979	L.C.R.C. #1393	Moore & Bruggink	1" Iron
1982	L.C.R.C. #3142	Moore & Bruggink	Fnd. 3/4" Iron / Set K.C. Monument
1994	L.C.R.C. #8069	Glaza & Associates	K.C. Monument

P.A. 345 1990 KENT COUNTY
 PEER APPROVED 7/24/97
 CHAIRMAN Randy Kolehouse
 K.C. Monument


This corner was originally approved by the Kent County Remonumentation Peer Group and monumented by Moore & Bruggink on 6/22/82 and was recorded per L.C.R.C. #3142.

- B. Description of corner evidence found and/or method applied in restoring or reestablishing corner:
- I-4 Found a Standard Kent County Monument on line of a tree row running East and West and 20' ± East of a tree row running North per L.C.R.C.'s #3816 and #7081 as set by Moore & Bruggink in place of a 3/4" iron they found which checked L.C.R.C. #1393 and the K.C. Surveyor's records.

L.C.R.C. #3142	L.C.R.C. #8069
K.C. Nail & Tag 5" Maple N 45° E 29.10'	K.C. remon tag & nail in NW side 10" Maple N 45° E 29.10'
K.C. Nail & Tag 8" Hickory South 16.08'	K.C. remon tag & nail in 10" Hickory South 16.08'
K.C. Nail & Tag 18" Oak S 75° W 18.14'	K.C. remon tag & nail in SE side 22" Oak S 75° W 18.42'
K.C. Nail & Tag 15" Oak N 88° W 28.18'	K.C. remon tag & nail in N side 15" Oak N 88° W 28.15'

The selected location is accepted by me and is generally accepted by professional surveyors as the best available evidence of the position of the original corner.

- C. Description of monument for corner and accessories established to perpetuate locating the position of the corner:
- I-4 Standard Kent County Monument
- Nail & K.C. remon. tag on NW side 10" Maple N 45° E 29.10'
 - Nail & K.C. remon. tag on W side 10" Hickory South 16.08'
 - Nail & K.C. remon. tag on SE side 22" Oak S 75° W 18.42'
 - Nail & K.C. remon. tag on N side 15" Oak N 88° W 28.15'

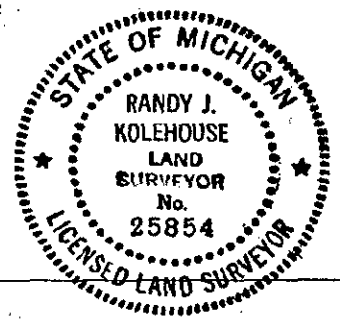

Signed by Randy J. Kolehouse Date 8-1-97
 EARTH TECH

Surveyor's Michigan License No. 25854