

MAR 03 1998

SECTION

LAND CORNER RECORDATION CERTIFICATE
Filing Requirement of Act 74, Mich. P.A. 1970
KENT COUNTY REMONUMENTATION

For corners in

Kent (County)

Located in: Ada Township

Corner Code #

- 1. Public Land Survey T 7N R 10W I-11
2. Property Controlling in Section S T R
3. Miscellaneous Property in Sec. S T R

- 4. Lot No. , Recorded Plat
5. Private Claims

Register of Deeds Stamp & File Number
10222
97 OCT 15 AM 8:51
STATE OF MICHIGAN COUNTY OF KENT RECEIVED FOR RECORD


I, Randy Kolehouse, in a field survey on January 30, 1997, do hereby certify that under requirements of P.A. 74 Michigan P.A. of 1970, the corner points mentioned in lines 1 and 2 above were in conformance with regulations and rules therefore as required in the current manual of survey instructions of the United States Department of the Interior, Bureau of Land Management or by a decree of a Court of Law and/or that the corner points mentioned in lines 3, 4 and 5 above were in conformance with the rules of the Michigan Board of Land Surveyors or by a Decree of a Court of Law; established, re-established, monumented, re-monumented, recovered, found as expressed below:

NOTE: Not more than 4 corners, all in the same town and range, may be recorded on this certificate.

A. Description of original monument and accessories and/or subsequent restoration:

Table with 5 columns: Year, Description, Surveyor, Monument Type, and Date. Rows include 1831 G.L.O. Notes, 1932 Witness Map, 1971 L.C.R.C. #20, 1981 L.C.R.C. #2592, and 1994 L.C.R.C. #8076.

P.A. 345 1990 KENT COUNTY PEER APPROVED 5/22/97
CHAIRMAN Harry Thelmer

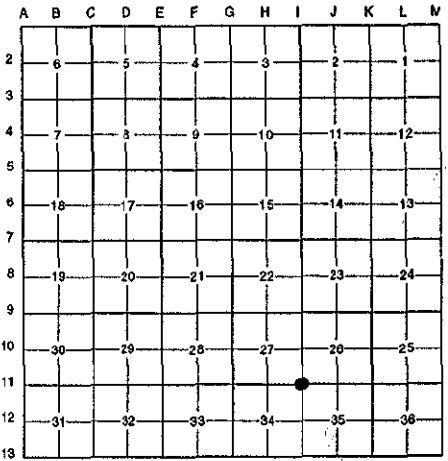

This corner was originally approved by the Kent County Remonumentation Peer Group and monumented by Rob Jonker on 12/28/81 and was recorded per L.C.R.C. #2592.

B. Description of corner evidence found and/or method applied in restoring or reestablishing corner:

I-11 Found a Standard Kent County Monument 5' +/- West of the West curb of Bailey Drive (bit.) and 5' +/- North of the North curb of Vergennes Street per L.C.R.C.'s #2592 and #8076 as set by Rob Jonker in place of a 1/2" x 35" rod he found with cap #18655 which checked L.C.R.C. #20 and the K.C. Surveyor's records.

L.C.R.C. #2592

L.C.R.C. #8076

Remon. tag on S side p. pole N 77° E 73.17'
Chisled "X" on E end drive culv. S 82° W 41.86'
Chisled "X" on top curb S 27° E 5.11'
Chisled "X" on top curb N 72° E 7.10'
C/L "C" of pavement of Vergennes & Bailey S 20° E 47' m/l

K.C. remon. tag & nail in S side P. pole N 77° E 73.17' (m. 73.21')
Chisled "X" on East end of drive culvert S 82° W 41.86'
Chisled "X" on top curb S 27° E 5.11'
Chisled "X" on top curb N 72° E 7.10'
C/L "X" of pavement of Vergennes & Bailey S 20° E 47' m/l

The selected location is accepted by me and is generally accepted by professional surveyors as the best available evidence of the position of the original corner.

C. Description of monument for corner and accessories established to perpetuate locating the position of the corner:

I-11 Standard Kent County Monument

Nail & K.C. remon. tag on S side P. pole N 77° E 73.21'
Chisled "X" on E end of drive culvert S 82° W 41.86'
Chisled "X" on top curb S 27° E 5.11'
Chisled "X" on top curb N 72° E 7.10'
Nail & K.C. remon. tag on top post of guard rail S 40° E 80.99'
Nail & K.C. remon. tag on top post of guard rail S 05° W 67.68'



Signed by Randy J. Kolehouse Date 8-1-97

Surveyor's Michigan License No. 25854