

MAR 03 1998

SECTION

LAND CORNER RECORDATION CERTIFICATE
Filing Requirement of Act 74, Mich. P.A. 1970
KENT COUNTY REMONUMENTATION

For corners in

Kent (County)	Located in:	Ada Township	Corner Code #
1. Public Land Survey	T <u>7N</u>	R <u>10W</u>	<u>I-12</u>
	T _____	R _____	_____
	T _____	R _____	_____
	T _____	R _____	_____
2. Property Controlling in Section	S _____	T _____	R _____
	S _____	T _____	R _____
3. Miscellaneous Property in Sec.	S _____	T _____	R _____
	S _____	T _____	R _____

REG. OF DEEDS

Lucy St. Grand

97 OCT 15 AM 8:51

STATE OF MICHIGAN
 COUNTY OF KENT
 RECEIVED FOR RECORD

10223

Register of Deeds Stamp & File Number

4. Lot No. _____, Recorded Plat _____
 5. Private Claims _____

I, Randy Kolehouse, in a field survey on February 18 19 97, do hereby certify that under requirements of P.A. 74 Michigan P.A. of 1970, the corner points mentioned in lines 1 and 2 above were in conformance with regulations and rules therefore as required in the current manual of survey instructions of the United States Department of the interior, Bureau of Land Management or by a decree of a Court of Law and/or that the corner points mentioned in lines 3, 4 and 5 above were in conformance with the rules of the Michigan Board of Land Surveyors or by a Decree of a Court of Law; established, re-established, monumented, re-monumented, recovered, found as expressed below:

NOTE: Not more than 4 corners, all in the same town and range, may be recorded on this certificate.

A. Description of original monument and accessories and/or subsequent restoration:

I-12	1831	G.L.O. Notes	Mullett	Set Post
	1941?	Notes	Williams & Works	Set Iron
	1991	L.C.R.C. #5762	T. Chettleburgh	Set K.C. Monument at Intersection of 1/4 Lines
	1995	L.C.R.C. #8077	Glaza & Associates	K.C. Monument

This corner was originally approved by the Kent County Remonumentation Peer Group and monumented by T. Chettleburgh on 2/5/91 and was recorded per L.C.R.C. #5762.

B. Description of corner evidence found and/or method applied in restoring or reestablishing corner:

I-12 Found a Standard Kent County Monument in the woods 4' South of a fence line running East and West per L.C.R.C.'s #5762 and #8077 as set by T. Chettleburgh using survey records of Williams & Works.

L.C.R.C. #5762

L.C.R.C. #8077

KC Remon tag in E. side of 15" Oak N 16° E 70.29'
 KC Remon tag in NW side of 8" Ash N 50° E 8.10'
 KC Remon tag in NE side of 27" Maple S 72° E 24.57'
 KC Remon tag in W. side of 17" Maple S 06° W 42.41'
 KC Remon tag in SE side of 18" Maple S 38° W 73.76'
 KC Remon tag in NW side of 18" Sycamore (Quad) S 71° W 70.34'
 KC Remon tag in SW side of 14" Ash N 60° W 18.31'


K.C. remon tag & nail in E side 15" Oak N 16° E 70.29'
 K.C. remon tag & nail in NW side 8" Ash N 50° E 8.10'
 K.C. remon tag & nail in NE side 27" Maple S 72° E 24.57'
 K.C. remon tag & nail in W side 17" Maple S 06° W 42.41'
 K.C. remon tag & nail in SE side 18" Maple S 38° W 73.76'
 K.C. remon tag & nail in NW side 18" Sycamore (Quad) S 71° W 70.34'
 K.C. remon tag & nail in SW side 14" Ash N 60° W 18.31'

The selected location is accepted by me and is generally accepted by professional surveyors as the best available evidence of the position of the original corner.

C. Description of monument for corner and accessories established to perpetuate locating the position of the corner:

I-12 Standard Kent County Monument

Nail & K.C. remon. tag on E side 15" Oak N 16° E 70.29'
 Nail & K.C. remon. tag on NW side 8" Ash N 50° E 8.10'
 Nail & K.C. remon. tag on NE side 27" Maple S 72° E 24.57'
 Nail & K.C. remon. tag on W side 20" Maple S 06° W 42.41'
 Nail & K.C. remon. tag on SE side 20" Maple S 38° W 73.76'
 Nail & K.C. remon. tag on NW side 20" Sycamore (Quad) S 71° W 70.34'

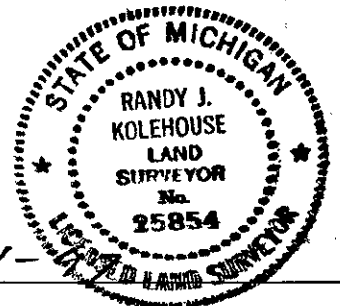

Signed by *Randy J. Kolehouse* Date 8-1-97
 EARTH TECH

Surveyor's Michigan License No. 25854

P.A. 345 1990 KENT COUNTY
 PEER APPROVED 5/22/97
 CHAIRMAN *Harry Hubert*