

SURVEY & REMONUMENTATION

MAR 03 1998

SECTION

LAND CORNER RECORDATION CERTIFICATE
Filing Requirement of Act 74, Mich. P.A. 1970
KENT COUNTY REMONUMENTATION


For corners in

Kent (County)	Located in: Township	Ada	Corner Code #
1. Public Land Survey	T <u>7N</u> R <u>10W</u>		<u>J-1</u>
	T _____ R _____		_____
	T _____ R _____		_____
	T _____ R _____		_____
2. Property Controlling in Section	S _____ T _____ R _____		_____
	S _____ T _____ R _____		_____
3. Miscellaneous Property in Sec.	S _____ T _____ R _____		_____
	S _____ T _____ R _____		_____
4. Lot No. _____, Recorded Plat _____			
5. Private Claims _____			

STATE OF MICHIGAN
 COUNTY OF KENT
 RECEIVED FOR RECORD
 97 NOV 14 AM 9:01
 REG. OF DEEDS
Lucy Standa

10316
 Register of Deeds Stamp & File Number

I, Randy Kolehouse, in a field survey on April 11 19 97, do hereby certify that under requirements of P.A. 74 Michigan P.A. of 1970, the corner points mentioned in lines 1 and 2 above were in conformance with regulations and rules therefore as required in the current manual of survey instructions of the United States Department of the Interior, Bureau of Land Management or by a decree of a Court of Law and/or that the corner points mentioned in lines 3, 4 and 5 above were in conformance with the rules of the Michigan Board of Land Surveyors or by a Decree of a Court of Law; established, re-established, monumented, re-monumented, recovered, found as expressed below:

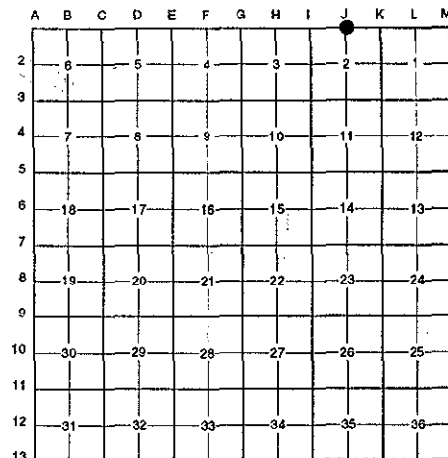

NOTE: Not more than 4 corners, all in the same town and range, may be recorded on this certificate.

A. Description of original monument and accessories and/or subsequent restoration:

J-1	This corner was not originally set by the G.L.O.
1968	Witness Map K.C. Surveyor Iron
1973	L.C.R.C. #532 Exxel Engineering "T" Iron
1984	L.C.R.C. #3954 Exxel Engineering Fnd. "T" Iron / Set K.C. Monument
1989	L.C.R.C. #5242 J. Bueche K.C. Monument

Note: This corner is not common with J-13, T8N, R10W.

This corner was originally approved by the Kent County Remonumentation Peer Group and monumented by Exxel Engineering on 9/7/84 and was recorded per L.C.R.C. #3954.

B. Description of corner evidence found and/or method applied in restoring or reestablishing corner:

J-1 Found a Standard Kent County Monument (top broken off) on the Township line at the C/L of 4 Mile Road (gravel) running East and West per L.C.R.C.'s #3954 and #5242 as set by Exxel Engineering in place of a badly bent "T" iron they found which checked L.C.R.C. #532 and the K.C. Surveyor's records.

L.C.R.C. #3954

L.C.R.C. #5242

- Nail & remon tag in N sde 4" W. Cherry S 75° E 111.90'
- Nail & remon tag in S sde 3" Hickory N 75° E 92.00'
- Nail & remon tag in W sde 6" Elm S 12° W 73.30'
- Nail & remon tag in N sde double 8" Sassafrass S 70° W 56.16'
- Nail & remon tag in N sde 22" Maple S 88° W 207.76'
- S 1/4 corner Section 35, T8N, R10W (C.I. Monument) East 164.47'

- Nail & remon. tag in N side 6" W. Cherry S 75° E 111.90'
- Nail & remon. tag in S side 6" Hickory N 75° E 92.00'
- Nail & remon. tag in W side 10" Elm S 12° W 73.30'
- Nail & remon. tag in N side double 12" Sassafrass S 70° W 56.16'
- Nail & remon. tag in N side 16" Maple S 88° W 207.76'
- S 1/4 corner Sec. 35, T8N, R10W (K.C. Mon.) E. 164.47'

The selected location is accepted by me and is generally accepted by professional surveyors as the best available evidence of the position of the original corner.


C. Description of monument for corner and accessories established to perpetuate locating the position of the corner:

J-1 Reset Standard Kent County Monument

- Nail & K.C. remon. tag on N side 6" Wild Cherry S 75° E 111.90'
- Nail & K.C. remon. tag on S side 6" Hickory N 75° E 92.00'
- Nail & K.C. remon. tag on W side 10" Elm S 12° W 73.30'
- Nail & K.C. remon. tag on N side 12" double Sassafras S 70° W 56.16'
- Nail & K.C. remon. tag on N side 26" Maple S 88° W 207.76'
- K.C. Mon. S 1/4 Sec. 35, T8N, R10W, East 164.47'

Signed by Randy J. Kolehouse

Date 9/23/97

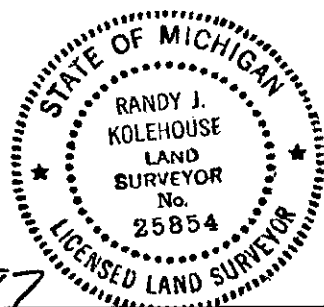

Surveyor's Michigan License No. 25854

P.A. 345 1990 KENT COUNTY
 PEER APPROVED 9/28/97
 CHAIRMAN Harry Huber
FORM APPROVED BY MICHIGAN STATE BOARD OF LAND SURVEYORS, JAN 28, 1971
 REVISED MAY 14, 1975
 REVISED JAN., 1983