

SURVEY & REMONUMENTATION

MAR 03 1998

LAND CORNER RECORDATION CERTIFICATE
Filing Requirement of Act 74, Mich. P.A. 1970
KENT COUNTY REMONUMENTATION

For corners in **SECTION**

<u>Kent</u> (County)	Located in: <u>Ada</u> Township	Corner Code #
1. Public Land Survey	T <u>7N</u> R <u>10W</u>	<u>J-9</u>
	T _____ R _____	_____
	T _____ R _____	_____
	T _____ R _____	_____
2. Property Controlling in Section	S _____ T _____ R _____	_____
	S _____ T _____ R _____	_____
3. Miscellaneous Property in Sec.	S _____ T _____ R _____	_____
	S _____ T _____ R _____	_____


STATE OF MICHIGAN
 COUNTY OF KENT
 RECEIVED FOR RECORD
 97 OCT 15 AM 8:52
 REG. OF DEEDS
Luci St. Bond

10226

Register of Deeds Stamp & File Number

4. Lot No. _____, Recorded Plat _____
 5. Private Claims _____

I, Randy Kolehouse, in a field survey on July 9 19 97, do hereby certify that under requirements of P.A. 74 Michigan P.A. of 1970, the corner points mentioned in lines 1 and 2 above were in conformance with regulations and rules therefore as required in the current manual of survey instructions of the United States Department of the interior, Bureau of Land Management or by a decree of a Court of Law and/or that the corner points mentioned in lines 3, 4 and 5 above were in conformance with the rules of the Michigan Board of Land Surveyors or by a Decree of a Court of Law; established, re-established, monumented, re-monumented, recovered, found as expressed below:

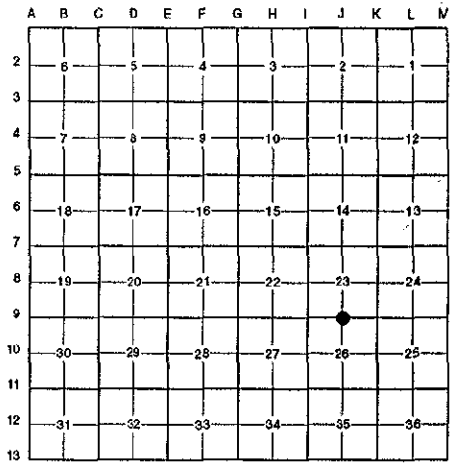

NOTE: Not more than 4 corners, all in the same town and range, may be recorded on this certificate.

A. Description of original monument and accessories and/or subsequent restoration:

J-9	1831	G.L.O. Notes	Mullett	Set Post
	1956	Witness Map	K.C. Surveyor	Concrete Monument
	1974	L.C.R.C. #705	Exxel Engineering	Concrete Monument
	1982	L.C.R.C. #3151	Moore & Bruggink	Fnd. 4" x 4" Concrete Mon. Set K.C. Monument
	1995	L.C.R.C. #8082	Glaza & Associates	K.C. Monument

PEER APPROVED 7/29/97
 CHAIRMAN *Harry Hubert*
 P.A. 345 1990 KENT COUNTY


This corner was originally approved by the Kent County Remonumentation Peer Group and monumented by Moore & Bruggink on 6/18/82 and was recorded per L.C.R.C. #3151.

- B. Description of corner evidence found and/or method applied in restoring or reestablishing corner:
 J-9 Found a Standard Kent County Monument 400' ± Westerly of house #310 Greentree Lane on line of a fence line running East and West per L.C.R.C.'s #3151 and #8082 as set by Moore & Bruggink in place of a 4" x 4" concrete monument they found which checked L.C.R.C. #705 and the K.C. Surveyor's records.

L.C.R.C. #3151	L.C.R.C. #8082
KC Nail & Tag 17" Oak West 16.72'	K.C. remon tag & nail in N side 17" Oak West 16.13' (m. 16.21')
KC Nail & Tag 15" Oak North 18.44'	K.C. remon tag & nail in W side 15" Oak North 18.40'
KC Nail & Tag 8" Oak N 70° E 38.43'	K.C. remon tag & nail in S side 12" Oak N 70° E 38.41'
KC Nail & Tag 18" Locust S 80° E 22.50'	K.C. remon tag & nail in N side 18" Locust S 80° E 22.53'
KC Nail & Tag 20" Oak South 37.82'	K.C. remon tag & nail in W side 22" Oak South 37.80'

The selected location is accepted by me and is generally accepted by professional surveyors as the best available evidence of the position of the original corner.

- C. Description of monument for corner and accessories established to perpetuate locating the position of the corner:
 J-9 Standard Kent County Monument
 Nail & K.C. remon. tag on N side 17" Oak N 90° W 16.21'
 Nail & K.C. remon. tag on W side 15" Oak N 06° E 18.40'
 Nail & K.C. remon. tag on S side 12" Oak N 70° E 38.41'
 Nail & K.C. remon. tag on N side 18" Locust S 80° E 22.53'
 Nail & K.C. remon. tag on W side 22" Oak S 12° W 37.80'

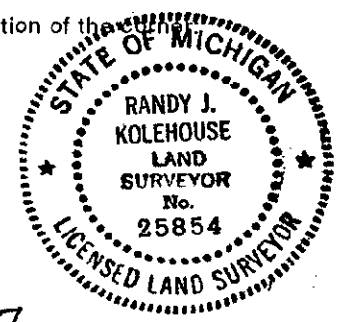

Signed by *Randy J. Kolehouse* Date 8-1-97
 Surveyor's Michigan License No. 25854