

OCT 28 1994

COMMISSION

KENT COUNTY REMONUMENTATION MAINTENANCE ADA TWP.

LAND CORNER RECORDATION CERTIFICATE Filing Requirement of Act 74, Mich. P.A. 1970

STATE OF MICHIGAN COUNTY OF KENT RECEIVED FOR RECORD

94 JUL -5 PM 3:12

For corners in KENT COUNTY (County)

Table with 3 columns: Located In, Corner Code #, and survey details. Includes entries for Public Land Survey, Property Controlling in Section, and Miscellaneous Property in Sec.

REG. OF DEEDS

6952

Register of Deeds Stamp & File Number

4. Lot No. , Recorded Plat
5. Private Claims

Grid table with columns A-M and rows 2-13. Cell J-12 contains the number 35.

I, William R. Byl, in a field survey on June 20, 1994, do hereby certify that under requirements of P.A. 74, Michigan P.A. of 1970, the corner points mentioned in lines 1 and 2 above were in conformance with regulations and rules therefore as required in the current manual of survey instructions of the United States Department of the Interior, Bureau of Land Management or by a decree of a Court of Law and/or that the corner points mentioned in lines 3, 4 and 5 above were in conformance with the rules of the Michigan Board of Land Surveyors or by a Decree of a Court of Law; established, re-established, monumented, re-monumented, recovered, found as expressed below:

NOTE: Not more than 4 corners, all in the same town and range, may be recorded on this certificate.

A. Description of original monument and accessories and/or subsequent restoration:

- J-12 Williams & Works
1903 Found old stake, set new wood stake & stone
1930 Found remains of stake-found stone, set iron pipe
1969 Found iron pipe, took witnesses
1983 Did not find iron pipe, set "T" iron from 1969 wits. Recorded LCRC #3625
Nail N. side 14" Oak West 15.30' Iron with cap #5132 East 2.0'
Nail E. side 14" Oak North 43.68' Iron is in East-West fence
Nail SE side 24" Oak S55°W 61.42'
Nail S. side 14" Ash East 28.03'

B. Description of corner evidence found and/or method applied in restoring or reestablishing corner:


J-12 Found "T" iron, fits C/L witness trees m/1, found capped iron #5132 East 1.71' Also found Iron Pipe 12" below grade.

Corner "L" on recorded survey of Sec. 35-7-10
Recorded survey L265 P20

P.A. 345 1990 KENT COUNTY PEER APPROVED 3/24/94 CHAIRMAN Harry Hubert

C. Description of monument for corner and accessories established to perpetuate locating the position of the corner:

- J-12 Replaced "T" Iron and Iron Pipe with Standard Kent County Monument
Set Nail & KC Remon. tag N. side 18" Oak S90°W 15.09'
Set Nail & KC Remon. tag E. side 18" Oak N00°E 43.72'
Set Nail & KC Remon. tag SE side 30" Oak S55°W 61.55'
Set Nail & KC Remon. tag S. side 18" Ash N90°E 28.32'
Capped Iron #5132 East 1.71'

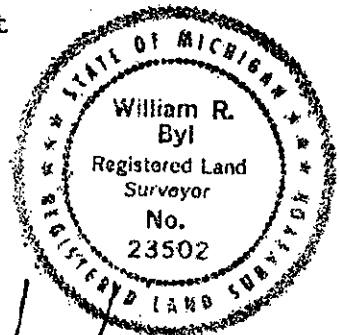

Signed by [Signature] Surveyor's Michigan License No. 23502

Date 06/27/94