

# SURVEY & REMONUMENTATION

MAR 03 1998

## LAND CORNER RECORDATION CERTIFICATE Filing Requirement of Act 74, Mich. P.A. 1970 KENT COUNTY REMONUMENTATION

For corners in	<b>SECTION</b>	Located in:	Ada	Corner Code #
<u>Kent</u>		Township		
(County)				
1. Public Land Survey		T <u>7N</u> R <u>10W</u>		<u>K-1</u>
		T _____ R _____		_____
		T _____ R _____		_____
		T _____ R _____		_____
2. Property Controlling in Section	S _____ T _____ R _____			_____
	S _____ T _____ R _____			_____
3. Miscellaneous Property in Sec.	S _____ T _____ R _____			_____
	S _____ T _____ R _____			_____

STATE OF MICHIGAN  
COUNTY OF KENT  
RECEIVED FOR RECORD

97 OCT 15 AM 8:52

REG. OF DEEDS

10228

Register of Deeds Stamp & File Number

4. Lot No. \_\_\_\_\_, Recorded Plat \_\_\_\_\_


5. Private Claims \_\_\_\_\_

I, Randy Kolehouse, in a field survey on April 11 19 97, do hereby certify that under requirements of P.A. 74 Michigan P.A. of 1970, the corner points mentioned in lines 1 and 2 above were in conformance with regulations and rules therefore as required in the current manual of survey instructions of the United States Department of the interior, Bureau of Land Management or by a decree of a Court of Law and/or that the corner points mentioned in lines 3, 4 and 5 above were in conformance with the rules of the Michigan Board of Land Surveyors or by a Decree of a Court of Law; established, re-established, monumented, re-monumented, recovered, found as expressed below:

**NOTE: Not more than 4 corners, all in the same town and range, may be recorded on this certificate.**

A. Description of original monument and accessories and/or subsequent restoration:

K-1	1831 G.L.O. Notes	Mullett	Set Post	
	1968 Witness Map	K.C. Surveyor	Iron	
	1973 L.C.R.C. #532	Exxel Engineering	"T" Iron	
	1984 L.C.R.C. #3967	Exxel Engineering	Fnd. "T" Iron / Set K.C. Monument	
	1989 L.C.R.C. #5243	J. Bueche	K.C. Monument	

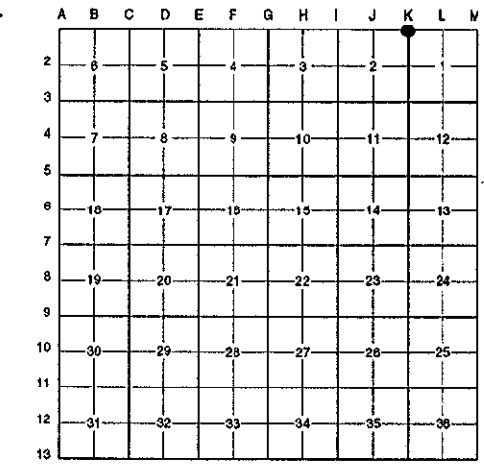

P.A. 345 1990 KENT COUNTY  
PEER APPROVED 5/22/97  
CHAIRMAN Harry Wabers

Note: This corner is not common with K-13, T8N, R10W.

This corner was originally approved by the Kent County Remonumentation Peer Group and monumented by Exxel Engineering on 9/7/84 and was recorded per L.C.R.C. #3967.

B. Description of corner evidence found and/or method applied in restoring or reestablishing corner:

K-1 Found a Standard Kent County Monument (broken) on Township line at the C/L of 4 Mile Road (gravel) running East and West and 12' West of the C/L of Giles Road (gravel) running South per L.C.R.C.'s #3967 and #5243 as set by Exxel Engineering in place of a "T" iron they found 0.15' North of the Township line per L.C.R.C. #532 and the K.C. Surveyor's records.

L.C.R.C. #3967	L.C.R.C. #5243
Nail & remon tag in E sde 10" Walnut S 17° W 51.06'	Nail & remon. tag in E side 12" Walnut S 17° W 51.06' (m. 51.18')
Nail & remon tag in W sde 6" Maple S 30° E 55.87'	Nail & remon. tag in W side 10" Maple S 30° E 55.87' (m. 56.25')
Nail & remon tag in S sde 10" W. Cherry N 61° W 57.18'	Nail & remon. tag in S side 12" W. Cherry N 61° W 57.18' (m. 56.90')
Nail & remon tag in N sde 14" Maple S 84° W 134.00'	Nail & remon. tag in N side 16" Maple S 84° W 134.00' (m. 133.82')
SE cor Section 35, T8N, R10W (C.I. Monument) East 128.64'	SE cor. Section 35, T8N, R10W (C.I. Monument) East 128.64' (m. 128.74')
	On C/L gravel E-W
	C/L gravel S., E. 12' ±

The selected location is accepted by me and is generally accepted by professional surveyors as the best available evidence of the position of the original corner.

C. Description of monument for corner and accessories established to perpetuate locating the position of the corner:

K-1 Reset a 4" x 30" Standard Kent County Monument

Nail & K.C. remon. tag on E side 12" Walnut S 17° W 51.18'

Nail & K.C. remon. tag on W side 10" Maple S 30° E 56.25'

Nail & K.C. remon. tag on S side 12" Wild Cherry N 61° W 56.90'

Nail & K.C. remon. tag on N side 16" Maple S 84° W 133.82'

K.C. Mon. SE Corner Sec. 35, T8N, R10W, East 128.74'

Signed by Randy J. Kolehouse Date 8-1-97

EARTH TECH

Surveyor's Michigan License No. 25854

