

SURVEY & REMONUMENTATION

MAR 03 1998

LAND CORNER RECORDATION CERTIFICATE
Filing Requirement of Act 74, Mich. P.A. 1970
KENT COUNTY REMONUMENTATION

For corners in **SECTION**
Kent
 (County)

Located in: Ada Township Corner Code #
 T 7N R 10W K-3
 T _____ R _____
 T _____ R _____
 T _____ R _____
 S _____ T _____ R _____
 S _____ T _____ R _____
 S _____ T _____ R _____
 S _____ T _____ R _____


STATE OF MICHIGAN
 COUNTY OF KENT
 RECEIVED FOR RECORD
 97 OCT 15 AM 8:52
 REG. OF DEEDS
Handwritten signature

10230

Register of Deeds Stamp & File Number

4. Lot No. _____, Recorded Plat _____
 5. Private Claims _____

I, Randy Kolehouse, in a field survey on April 11 19 97, do hereby certify that under requirements of P.A. 74 Michigan P.A. of 1970, the corner points mentioned in lines 1 and 2 above were in conformance with regulations and rules therefore as required in the current manual of survey instructions of the United States Department of the interior, Bureau of Land Management or by a decree of a Court of Law and/or that the corner points mentioned in lines 3, 4 and 5 above were in conformance with the rules of the Michigan Board of Land Surveyors or by a Decree of a Court of Law; established, re-established, monumented, re-monumented, recovered, found as expressed below:

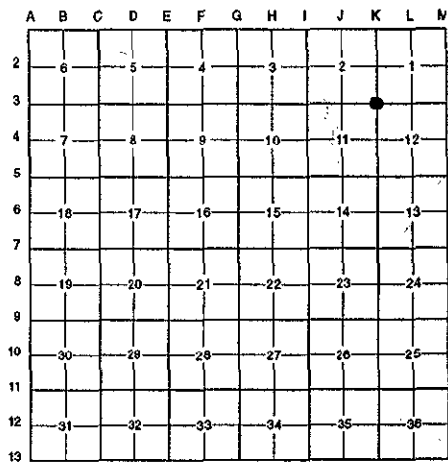

NOTE: Not more than 4 corners, all in the same town and range, may be recorded on this certificate.

A. Description of original monument and accessories and/or subsequent restoration:

K-3	1831	G.L.O. Notes	Mullett	Set Post
	1940	Witness Map	K.C. Surveyor	Concrete Monument
	1973	L.C.R.C. #532	Exxel Engineering	Concrete Monument
	1981	L.C.R.C. #2596	Jonker Land Surveys	Fnd. Concrete Monument / Set K.C. Monument
	1994	L.C.R.C. #8086	Glaza & Associates	K.C. Monument

P.A. 345 1990 KENT COUNTY
 PEER APPROVED 5/22/97
 CHAIRMAN Handwritten signature

This corner was originally approved by the Kent County Remonumentation Peer Group and monumented by Rob Jonker on 12/14/81 and was recorded per L.C.R.C. #2596.

B. Description of corner evidence found and/or method applied in restoring or reestablishing corner:
 K-3 Found a bent Standard Kent County Monument at the C/L intersection of 3 Mile Road (gravel) running East and West and Giles Avenue (gravel) running North per L.C.R.C.'s #2596 and #8086 as set by Rob Jonker in place of a 4" x 36 concrete monument he found which checked L.C.R.C. #532 and the K.C. Surveyor's records. Reset monument using remaining witnesses.

L.C.R.C. #2596	L.C.R.C. #8086
Remon. tag on W side 22" Oak S 12° E 26.99'	K.C. remon tag & nail in W side 24" Oak S 12° E 26.71' (m. 26.53')
Remon. tag on S side fence post N 70° W 58.73'	K.C. remon tag & nail in S side fence post N 70° W 58.48' (m. 58.35')
Remon. tag on NW side 6" Elm clump N 51° E 46.29'	K.C. remon tag & nail in NW side 6" Elm clump N 51° E 46.24' (m. 46.39')
In line with C/L gravel to N & E	C/L of traveled way NE'ly 25' m/l
	In line with C/L gravel to N & E

The selected location is accepted by me and is generally accepted by professional surveyors as the best available evidence of the position of the original corner.

C. Description of monument for corner and accessories established to perpetuate locating the position of the corner:
 K-3 Reset a 4" x 30" Standard Kent County Monument
 Nail & K.C. remon. tag on W side 24" Oak S 12° E 26.53'
 Nail & K.C. remon. tag on S side fence post N 70° W 58.35'
 Nail & K.C. remon. tag on NW side 6" Elm clump N 51° E 46.39'
 Nail & K.C. remon. tag on N side 6" Ash S 58° W 117.95'



Signed by Randy J. Kolehouse
 EARTH TECH

Date 5-1-97

Surveyor's Michigan License No. 25854