

# SURVEY & REMONUMENTATION

MAR 03 1998

## LAND CORNER RECORDATION CERTIFICATE Filing Requirement of Act 74, Mich. P.A. 1970 KENT COUNTY REMONUMENTATION

For corners in

<u>Kent</u>	<b>SECTION</b>	Located in:	Ada	Corner Code #
(County)		Township		
1. Public Land Survey		T <u>7N</u>	R <u>10W</u>	<u>K-9</u>
		T _____	R _____	_____
		T _____	R _____	_____
		T _____	R _____	_____
2. Property Controlling in Section	S _____	T _____	R _____	_____
	S _____	T _____	R _____	_____
3. Miscellaneous Property in Sec.	S _____	T _____	R _____	_____
	S _____	T _____	R _____	_____

4. Lot No. \_\_\_\_\_, Recorded Plat \_\_\_\_\_  
5. Private Claims \_\_\_\_\_

REG. OF DEEDS  
 97 OCT 15 AM 8:52  
 STATE OF MICHIGAN  
 COUNTY OF KENT  
 RECEIVED FOR RECORD

10235


Register of Deeds Stamp & File Number

I, Randy Kolehouse, in a field survey on January 30 19 97, do hereby certify that under requirements of P.A. 74 Michigan P.A. of 1970, the corner points mentioned in lines 1 and 2 above were in conformance with regulations and rules therefore as required in the current manual of survey instructions of the United States Department of the Interior, Bureau of Land Management or by a decree of a Court of Law and/or that the corner points mentioned in lines 3, 4 and 5 above were in conformance with the rules of the Michigan Board of Land Surveyors or by a Decree of a Court of Law; established, re-established, monumented, re-monumented, recovered, found as expressed below:

**NOTE: Not more than 4 corners, all in the same town and range, may be recorded on this certificate.**

A. Description of original monument and accessories and/or subsequent restoration:

K-9	1831	G.L.O. Notes	Mullet	Set Post
	1954	Witness Map	K.C. Surveyor	Iron
	1972	L.C.R.C. #347	Williams & Works	Concrete Monument
	1981	L.C.R.C. #2504	C. Hay	Fnd. Concrete Monument / Set K.C. Monument
	1994	L.C.R.C. #8092	Glaza & Associates	K.C. Monument

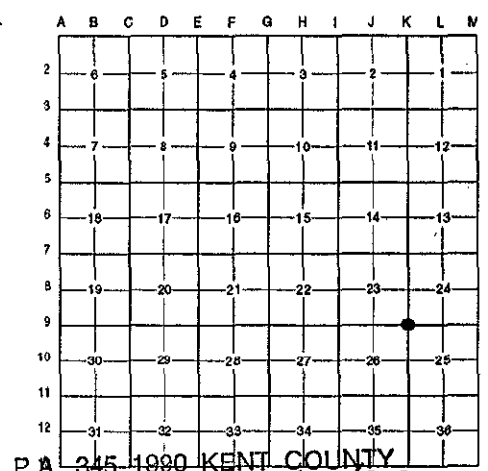

P.A. 345-1990 KENT COUNTY  
 PEER APPROVED 5/22/97  
 CHAIRMAN Henry Hufsch

This corner was originally approved by the Kent County Remonumentation Peer Group and monumented by C. Hay on 12/11/81 and was recorded per L.C.R.C. #2504.

B. Description of corner evidence found and/or method applied in restoring or reestablishing corner:  
 K-9 Found a Standard Kent County Monument at the C/L intersection of Bailey Drive running South and Bailey Drive running East ± 125' West of curve in road per L.C.R.C.'s #2504 and #8092 as set by C. Hay in place of a concrete monument he found which checked L.C.R.C. #347 and the K.C. Surveyor's records. Also found a 4' x 2" round metal pipe on South side of monument.

L.C.R.C. #2504

- Nail & remon. tag West side 15" Oak N 06° E 58.74'
- Nail & remon. tag SE side 21" Oak N 40° E 37.95'
- Nail & remon. tag SE side 12" Oak N 55° E 49.70'
- Nail & remon. tag NW side 12" Oak S 65° W 43.40'


L.C.R.C. #8092

- Nail & K.C. remon. tag in West side 24" Oak N 06° E 58.54'
- Nail & K.C. remon. tag in SE side 26" Oak N 40° E 37.89'
- Nail & K.C. remon. tag in SE side 14" Oak N 55° E 49.70'
- Nail & K.C. remon. tag in NW side 18" Oak S 65° W 43.43'

The selected location is accepted by me and is generally accepted by professional surveyors as the best available evidence of the position of the original corner.

C. Description of monument for corner and accessories established to perpetuate locating the position of the corner:

- K-9 Standard Kent County Monument
- Nail & K.C. remon. tag on W side 24" Oak N 06° E 58.54'
  - Nail & K.C. remon. tag on SE side 26" Oak N 40° E 37.89'
  - Nail & K.C. remon. tag on SE side 14" Oak N 55° E 49.70'
  - Nail & K.C. remon. tag on NW side 18" Oak S 65° W 43.43'
  - 8" Cherry N 05° E 18.03'
  - Nail & K.C. remon. tag on W side twin 8" Cherry S 25° W 35.05'

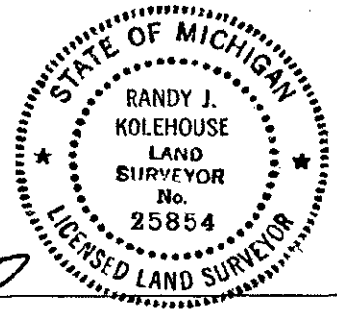

Signed by Randy J. Kolehouse Date 8-1-97  
 EARTH TECH

Surveyor's Michigan License No. 25854