

SURVEY & REMONUMENTATION

MAR 03 1998

SECTION

LAND CORNER RECORDATION CERTIFICATE
Filing Requirement of Act 74, Mich. P.A. 1970
KENT COUNTY REMONUMENTATION

For corners in

Kent
 (County)

Located in: Ada Township Corner Code #

1. Public Land Survey	T <u>7N</u>	R <u>10W</u>	<u>K-11</u>
	T _____	R _____	_____
	T _____	R _____	_____
	T _____	R _____	_____
2. Property Controlling in Section	S _____	T _____	R _____
	S _____	T _____	R _____
3. Miscellaneous Property in Sec.	S _____	T _____	R _____
	S _____	T _____	R _____

4. Lot No. _____, Recorded Plat _____
 5. Private Claims _____

STATE OF MICHIGAN
 COUNTY OF KENT
 RECEIVED FOR RECORD

97 OCT 15 AM 8:52

REG. OF DEEDS

[Signature]

10237

Register of Deeds Stamp & File Number

I, Randy Kolehouse, in a field survey on January 30 19 97, do hereby certify that under requirements of P.A. 74 Michigan P.A. of 1970, the corner points mentioned in lines 1 and 2 above were in conformance with regulations and rules therefore as required in the current manual of survey instructions of the United States Department of the interior, Bureau of Land Management or by a decree of a Court of Law and/or that the corner points mentioned in lines 3, 4 and 5 above were in conformance with the rules of the Michigan Board of Land Surveyors or by a Decree of a Court of Law; established, re-established, monumented, re-monumented, recovered, found as expressed below:

NOTE: Not more than 4 corners, all in the same town and range, may be recorded on this certificate.

A	B	C	D	E	F	G	H	I	J	K	L	M
2	6	5	4	3	2	1						
3												
4	7	8	9	10	11	12						
5												
6	18	17	16	15	14	13						
7												
8	19	20	21	22	23	24						
9												
10	30	29	28	27	26	25						
11												
12	31	32	33	34	35	36						
13												

A. Description of original monument and accessories and/or subsequent restoration:

K-11	1831	G.L.O. Notes	Mullett	Set Post	P.A. 345 1990 KENT COUNTY PEER APPROVED <i>5/22/97</i> CHAIRMAN <i>[Signature]</i>
	1933	Witness Map	K.C. Surveyor	Wagon Axle	
	N/A	Notes	Williams & Works	"T" Iron	
	1971	L.C.R.C. #60	Williams & Works	"T" Iron	
	1982	L.C.R.C. #3146	Moore & Bruggink	Fnd. "T" Iron / Set K.C. Monument	
	1994	L.C.R.C. #8094	Glaza & Associates	K.C. Monument	

This corner was originally approved by the Kent County Remonumentation Peer Group and monumented by Moore & Bruggink on 8/2/82 and was recorded per L.C.R.C. #3146.

B. Description of corner evidence found and/or method applied in restoring or reestablishing corner:

K-11 Found a Standard Kent County Monument 1' South of the C/L of Vergennes Street (bit.) running East and West and 10' ± East of the C/L of creek running North per L.C.R.C.'s #3146 and #8094 as set by Moore & Bruggink in place of a "T" iron they found over a 1" iron which checked L.C.R.C. #60, the notes of Williams & Works, and the K.C. Surveyor's records.

L.C.R.C. #3146

L.C.R.C. #8094

K.C. Nail & Tag 20" Oak N 15° W 36.91'
 K.C. Nail & Tag 26" Maple N 10° E 35.28'
 K.C. Nail & Tag Tri 20" Oak S 20° W 39.23'


K.C. tag & nail in 24" Oak N 15° W 36.75' (m. 36.76')
 K.C. tag & nail in 26" Maple N 10° E 34.99'
 K.C. tag & nail in 20" Tri. Oak S 20° W 39.23'
 Centerline pavement 1' North

The selected location is accepted by me and is generally accepted by professional surveyors as the best available evidence of the position of the original corner.

C. Description of monument for corner and accessories established to perpetuate locating the position of the corner:

K-11 Standard Kent County Monument

Nail & K.C. remon. tag on 24" Oak N 15° W 36.76'
 Nail & K.C. remon. tag on 26" Maple N 10° E 34.99'
 Nail & K.C. remon. tag on 20" triple Oak S 20° W 39.23'
 Nail & K.C. remon. tag on 18" Wild Cherry S 25° W 29.91'
 Center line pavement 1' North

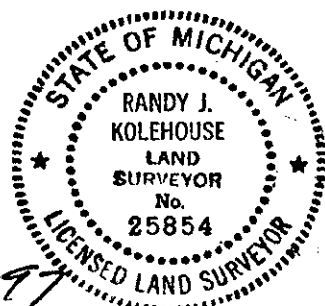

Signed by *[Signature]*
 EARTH TECH

Date 8-1-97

Surveyor's Michigan License No. 25854