

SURVEY & REMONUMENTATION

MAR 03 1998

LAND CORNER RECORDATION CERTIFICATE
Filing Requirement of Act 74, Mich. P.A. 1970
KENT COUNTY REMONUMENTATION

For corners in Kent SECTION _____
 (County)

Located in:	Ada	Corner Code #
Township		
1. Public Land Survey	T <u>7N</u> R <u>10W</u>	<u>L-1</u>
	T _____ R _____	_____
	T _____ R _____	_____
	T _____ R _____	_____
2. Property Controlling in Section	S _____ T _____ R _____	_____
	S _____ T _____ R _____	_____
3. Miscellaneous Property in Sec.	S _____ T _____ R _____	_____
	S _____ T _____ R _____	_____

STATE OF MICHIGAN
 COUNTY OF KENT
 RECEIVED FOR RECORD

97 OCT 15 AM 8:52

REG. OF DEEDS
Lucy Stand

10239

Register of Deeds Stamp & File Number

4. Lot No. _____, Recorded Plat _____
 5. Private Claims _____

I, Randy Kolehouse, in a field survey on January 30 19 97, do hereby certify that under requirements of P.A. 74 Michigan P.A. of 1970, the corner points mentioned in lines 1 and 2 above were in conformance with regulations and rules therefore as required in the current manual of survey instructions of the United States Department of the interior, Bureau of Land Management or by a decree of a Court of Law and/or that the corner points mentioned in lines 3, 4 and 5 above were in conformance with the rules of the Michigan Board of Land Surveyors or by a Decree of a Court of Law; established, re-established, monumented, re-monumented, recovered, found as expressed below:

	A	B	C	D	E	F	G	H	I	J	K	L	M
2	6	5	4	3	2	1							
3													
4	7	8	9	10	11	12							
5													
6	16	17	18	15	14	13							
7													
8	19	20	21	22	23	24							
9													
10	30	29	28	27	26	25							
11													
12	31	32	33	34	35	36							
13													

NOTE: Not more than 4 corners, all in the same town and range, may be recorded on this certificate.

A. Description of original monument and accessories and/or subsequent restoration:

- L-1 This corner was not originally set by the G.L.O.
- | | | | |
|------|----------------|-------------------|--------------------------------------|
| 1984 | L.C.R.C. #3966 | Exxel Engineering | Fnd. Square Iron / Set K.C. Monument |
| 1989 | L.C.R.C. #5244 | J. Bueche | K.C. Monument |

P.A. 345 1990 KENT COUNTY
 PEER APPROVED 5/22/97
 CHAIRMAN Harry Faber

Note: This corner is not common with L-13, T8N, R10W.

This corner was originally approved by the Kent County Remonumentation Peer Group and monumented by Exxel Engineering on 9/14/84 and was recorded per L.C.R.C. #3966.

B. Description of corner evidence found and/or method applied in restoring or reestablishing corner:


- L-1 Found a Standard Kent County Monument on the Township line 55' ± West of the C/L of Mc Cabe Avenue (bit.) running North and South and 4' South of the C/L of 4 Mile Road (gravel) running East and West per L.C.R.C.'s #3966 and #5244 as set by Exxel Engineering on line with the Southerly Section corners of Section 36, T8N, R10W, and 0.46' South of an existing square iron they found that checked the midpoint between K-1 and M-1 within 0.08'.

L.C.R.C. #3966	L.C.R.C. #5244
Nail & remon tag in E sde 12" Hickory S 13° W 21.72'	Nail & remon. tag in E side 14" Hickory S 13° W 21.72' (m. 21.74')
Nail & remon tag in N sde 14" Maple S 84° W 117.35'	Nail & remon. tag in N side 18" Maple S 84° W 117.35'
Nail & remon tag in S sde 12" Elm N 62° W 54.25'	Nail & remon. tag in S side 14" Elm N 62° W 54.25'
PK & remon tag in W sde P. Pole N 17° W 94.78'	PK & remon. tag in W side P. pole N 17° W 94.78' (m. 94.79')
SE cor hse fndn N 55° E 192.63'	SE cor. hse. fnd. N 55° E 192.63'
C/L N-S road East 55' ±	C/L N-S road East 55' ±
C/L E-W road North 4' ±	C/L E-W road North 4' ±

The selected location is accepted by me and is generally accepted by professional surveyors as the best available evidence of the position of the original corner.

C. Description of monument for corner and accessories established to perpetuate locating the position of the corner:

- L-1 Standard Kent County Monument
- Nail & K.C. remon. tag on E side 14" Hickory S 13° W 21.74"
 Nail & K.C. remon. tag on N side 18" Maple S 84° W 117.35'
 Nail & K.C. remon. tag on S side 14" Elm N 62° W 54.25'
 P.K. nail & remon. tag in W side P. pole N 17° W 94.79'
 SE corner house foundation N 55° E 192.63'

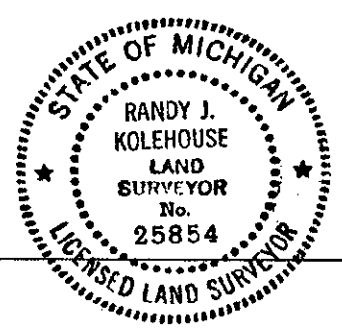

Signed by Randy J. Kolehouse Date 8-1-97
 EARTH TECH
 Surveyor's Michigan License No. 25854