

SURVEY & REMONUMENTATION

\$7.00
\$2.00

MAR 03 1998

LAND CORNER RECORDATION CERTIFICATE
Filing Requirement of Act 74, Mich. P.A. 1970
KENT COUNTY REMONUMENTATION

For corners in

SECTION

Kent (County)	Located in:	Ada Township	Corner Code #
1. Public Land Survey	T <u>7N</u>	R <u>10W</u>	<u>L-2</u>
	T _____	R _____	_____
	T _____	R _____	_____
	T _____	R _____	_____
2. Property Controlling in Section	S _____	T _____	R _____
	S _____	T _____	R _____
3. Miscellaneous Property in Sec.	S _____	T _____	R _____
	S _____	T _____	R _____
4. Lot No. _____, Recorded Plat _____			
5. Private Claims _____			

REG. OF DEEDS

Lucy Stand

97 DEC 15 AM 10:42

STATE OF MICHIGAN
COUNTY OF KENT
RECEIVED FOR RECORD

10374

Register of Deeds Stamp & File Number

I, Randy Kolehouse, in a field survey on October 10 19 97, do hereby certify that under requirements of P.A. 74 Michigan P.A. of 1970, the corner points mentioned in lines 1 and 2 above were in conformance with regulations and rules therefore as required in the current manual of survey instructions of the United States Department of the interior, Bureau of Land Management or by a decree of a Court of Law and/or that the corner points mentioned in lines 3, 4 and 5 above were in conformance with the rules of the Michigan Board of Land Surveyors or by a Decree of a Court of Law; established, re-established, monumented, re-monumented, recovered, found as expressed below:

NOTE: Not more than 4 corners, all in the same town and range, may be recorded on this certificate.

A. Description of original monument and accessories and/or subsequent restoration:

L-2 This corner was not originally set by the G.L.O.
1975 Survey Russell F. Donker & Assoc. "T" Iron

A	B	C	D	E	F	G	H	I	J	K	L	M
2	6	5	4	3	2	1						
3												
4	7	8	9	10	11	12						
5												
6	18	17	16	15	14	13						
7												
8	19	20	21	22	23	24						
9												
10	30	29	28	27	26	25						
11												
12	31	32	33	34	35	36						
13												

P.A. 345 1990 KENT COUNTY
PEER APPROVED 10/16/97
CHAIRMAN Randy Kolehouse

B. Description of corner evidence found and/or method applied in restoring or reestablishing corner:

L-2 Found a "T" iron on a tree row running West per witnesses from unrecorded Donker & Associates Survey. "T" iron is 0.5' South and 0.1' West of the intersection of 1/4 lines. Accepted "T" iron as Center of Section.


Unrecorded Donker & Assoc. Survey

- 8" Ash NW 10.15'
- 10" Walnut N 16.8'
- 12" Ash NE 15.9'
- C/L Mc Cabe Avenue. E 37.0'

The selected location is accepted by me and is generally accepted by professional surveyors as the best available evidence of the position of the original corner.

C. Description of monument for corner and accessories established to perpetuate locating the position of the corner:

- L-2 Replaced "T" Iron with a Standard Kent County Monument
- Nail & K.C. remon. tag on N side 30" Oak S 45° E 12.70'
 - Nail & K.C. remon. tag on NW side 20" Maple N 30° E 16.52'
 - Nail & K.C. remon. tag on W side 16" Oak N 05° E 17.62'
 - Nail & K.C. remon. tag on S side 14" Oak N 80° W 13.93'
 - Nail & K.C. remon. tag on W side 10" Maple S 30° W 31.61'

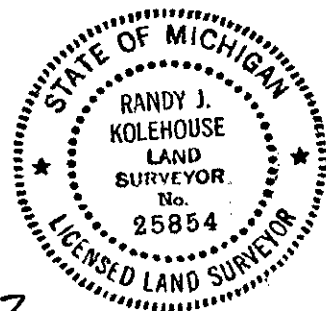

Signed by: Randy J. Kolehouse
EARTH TECH

Date: 12/5/97

Surveyor's Michigan License No. 25854