

SURVEY & REMONUMENTATION

MAR 03 1998

LAND CORNER RECORDATION CERTIFICATE
Filing Requirement of Act 74, Mich. P.A. 1970
KENT COUNTY REMONUMENTATION

For corners in SECTION
Kent
 (County)

Located in: Ada Corner Code #
 Township

1. Public Land Survey	T <u>7N</u>	R <u>10W</u>	<u>L-3</u>
	T _____	R _____	_____
	T _____	R _____	_____
	T _____	R _____	_____
2. Property Controlling in Section	S _____	T _____	R _____
	S _____	T _____	R _____
3. Miscellaneous Property in Sec.	S _____	T _____	R _____
	S _____	T _____	R _____

STATE OF MICHIGAN
 COUNTY OF KENT
 RECEIVED FOR RECORD
 97 OCT 15 AM 8:52
 REG. OF DEEDS
Lucy Stoddard

10240

Register of Deeds Stamp & File Number


4. Lot No. _____, Recorded Plat _____
 5. Private Claims _____

I, Randy Kolehouse, in a field survey on January 30 19 97, do hereby certify that under requirements of P.A. 74 Michigan P.A. of 1970, the corner points mentioned in lines 1 and 2 above were in conformance with regulations and rules therefore as required in the current manual of survey instructions of the United States Department of the Interior, Bureau of Land Management or by a decree of a Court of Law and/or that the corner points mentioned in lines 3, 4 and 5 above were in conformance with the rules of the Michigan Board of Land Surveyors or by a Decree of a Court of Law; established, re-established, monumented, re-monumented, recovered, found as expressed below:

NOTE: Not more than 4 corners, all in the same town and range, may be recorded on this certificate.

A. Description of original monument and accessories and/or subsequent restoration:

L-3	1831	G.L.O. Notes	Mullett	Set Post
	1940	Witness Map	K.C. Surveyor	Concrete Monument
	1977	L.C.R.C. #1128	Glaza & Associates	Iron in Monument Box
	1981	L.C.R.C. #2597	Jonker Land Surveys	Fnd. 1/2" Iron in Mon. Box / Set K.C. Monument in Mon. Box
	1994	L.C.R.C. #8098	Glaza & Associates	K.C. Monument

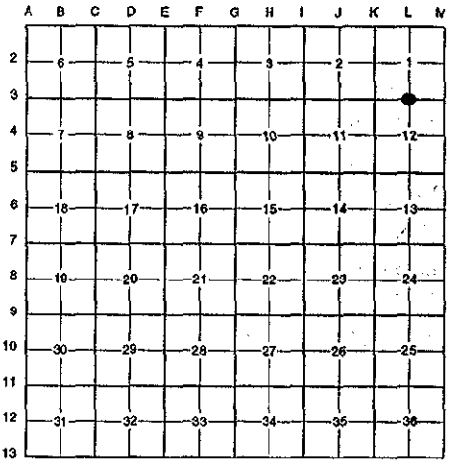

This corner was originally approved by the Kent County Remonumentation Peer Group and monumented by Rob Jonker on 12/11/81 and was recorded per L.C.R.C. #2597.

B. Description of corner evidence found and/or method applied in restoring or reestablishing corner:

L-3 Found a Standard Kent County Monument 1' West of the C/L intersection of Mc Cabe Avenue (bit.) running North and South and 3 Mile Road (gravel) running East and West per L.C.R.C.'s #2597 and #8098 as set by Rob Jonker in place of a 1/2" iron over a concrete monument he found in a monument box 10" below grade which checked L.C.R.C. #1128 and the K.C. Surveyor's records.

L.C.R.C. #2597

Remon. tag on SW side t. pole S 40° E 48.10'
 Remon. tag on NE side 30" Maple N 51° W 47.00'
 Remon. tag on NW side 18" Walnut S 53° W 47.52'
 SW corner house fnd. (conc.) N 52° E 96.02'
 C/L "X" of pavement is 1' East

L.C.R.C. #8098

K.C. remon. tag & nail in SW side T. pole S 40° E 48.10'
 K.C. remon. tag & nail in NE side 30" Maple N 51° W 46.80'
 K.C. remon. tag & nail in NW side 20" Walnut S 53° W 47.55'
 SW corner of house foundation (conc.) N 52° E 95.95'
 C/L "X" of pavement is 1' East

The selected location is accepted by me and is generally accepted by professional surveyors as the best available evidence of the position of the original corner.


C. Description of monument for corner and accessories established to perpetuate locating the position of the corner:

L-3 Standard Kent County Monument
 Nail & K.C. remon. tag on SW side T. pole S 40° E 48.10'
 Nail & K.C. remon. tag on NE side 30" Maple N 51° W 46.80'
 Nail & K.C. remon. tag on NW side 20" Walnut S 53° W 47.55'
 SW Cor. Conc. house foundation N 52° E 95.95'

P.A. 345 1990 KENT COUNTY

PEER APPROVED 5/22/97

CHAIRMAN *Harry Jonker*

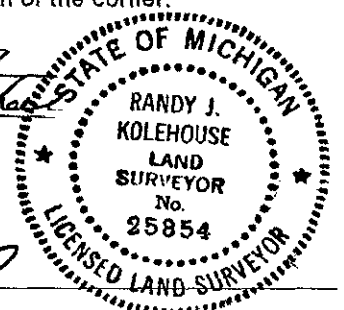

Signed by *Randy J. Kolehouse*
 EARTH TECH

Date 8-1-97

Surveyor's Michigan License No. 25854