

SURVEY & REMONUMENTATION

\$7.00
\$2.00

MAR 03 1998

LAND CORNER RECORDATION CERTIFICATE
Filing Requirement of Act 74, Mich. P.A. 1970
KENT COUNTY REMONUMENTATION

STATE OF MICHIGAN
COUNTY OF KENT
RECEIVED FOR RECORD
97 DEC 15 AM 10:43
REG. OF DEEDS
Lucy Standa

For corners in	SECTION	Located in:	Ada Township	Corner Code #
Kent (County)				
1. Public Land Survey		T <u>7N</u>	R <u>10W</u>	<u>L-10</u>
		T _____	R _____	_____
		T _____	R _____	_____
		T _____	R _____	_____
2. Property Controlling in Section	S _____	T _____	R _____	_____
	S _____	T _____	R _____	_____
3. Miscellaneous Property in Sec.	S _____	T _____	R _____	_____
	S _____	T _____	R _____	_____

10378

Register of Deeds Stamp & File Number

4. Lot No. _____, Recorded Plat _____
5. Private Claims _____

	A	B	C	D	E	F	G	H	I	J	K	L	M
2	6	5	4	3	2	1							
3													
4	7	8	9	10	11	12							
5													
6	18	17	16	15	14	13							
7													
8	19	20	21	22	23	24							
9													
10	30	29	28	27	26	25							
11													
12	31	32	33	34	35	36							
13													

I, Randy Kolehouse, in a field survey on August 6 19 97, do hereby certify that under requirements of P.A. 74 Michigan P.A. of 1970, the corner points mentioned in lines 1 and 2 above were in conformance with regulations and rules therefore as required in the current manual of survey instructions of the United States Department of the interior, Bureau of Land Management or by a decree of a Court of Law and/or that the corner points mentioned in lines 3, 4 and 5 above were in conformance with the rules of the Michigan Board of Land Surveyors or by a Decree of a Court of Law; established, re-established, monumented, re-monumented, recovered, found as expressed below:

NOTE: Not more than 4 corners, all in the same town and range, may be recorded on this certificate.

A. Description of original monument and accessories and/or subsequent restoration:

L-10 This corner was not originally set by the G.L.O.
N/A Witness Map K.C. Surveyor Gas Pipe

P.A. 345 1990 KENT COUNTY,
PEER APPROVED 9/29/97
CHAIRMAN Harry Hubert

B. Description of corner evidence found and/or method applied in restoring or reestablishing corner:


L-10 Found a 1" iron pipe 84' East of a barbed wire fence running North and South and 24' South of South end of fence per the K.C. Surveyor's records. Iron is 1.0' South and 0.1' West of the intersection of 1/4 lines. Accepted iron as Center of Section.

K.C. Witness Map
8" Oak N. 49.2'
6" Oak N.W. 23.9'
18" Pine S.E. 22.25'

The selected location is accepted by me and is generally accepted by professional surveyors as the best available evidence of the position of the original corner.

C. Description of monument for corner and accessories established to perpetuate locating the position of the corner:

L-10 Replaced 1" Iron Pipe with a Standard Kent County Monument
Nail & K.C. remon. tag on 40" Pine S 45° E 22'±
Nail & K.C. remon. tag on 18" Oak stump N 50° W 24'±
Nail & K.C. remon. tag on 20" Oak stump N 00° W 49'±

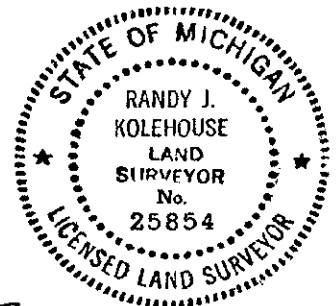

Signed by Randy J. Kolehouse
EARTH TECH

Date 11/20/97

Surveyor's Michigan License No. 25854