

# SURVEY & REMONUMENTATION

MAR 03 1998

## LAND CORNER RECORDATION CERTIFICATE Filing Requirement of Act 74, Mich. P.A. 1970 KENT COUNTY REMONUMENTATION

STATE OF MICHIGAN  
COUNTY OF KENT  
RECEIVED FOR RECORD  
97 OCT 15 AM 8:52  
REC. OF DEEDS  
*Tim Standa*

SECTION

For corners in Kent  
(County)

Located in: Ada Corner Code #  
Township


1. Public Land Survey	T <u>7N</u> R <u>10W</u>	<u>L-11</u>
	T _____ R _____	_____
	T _____ R _____	_____
	T _____ R _____	_____
2. Property Controlling in Section	S _____ T _____ R _____	_____
	S _____ T _____ R _____	_____
3. Miscellaneous Property in Sec.	S _____ T _____ R _____	_____
	S _____ T _____ R _____	_____

10244

Register of Deeds Stamp & File Number

4. Lot No. \_\_\_\_\_, Recorded Plat \_\_\_\_\_  
5. Private Claims \_\_\_\_\_

I, Randy Kolehouse, in a field survey on January 29 19 97, do hereby certify that under requirements of P.A. 74 Michigan P.A. of 1970, the corner points mentioned in lines 1 and 2 above were in conformance with regulations and rules therefore as required in the current manual of survey instructions of the United States Department of the interior, Bureau of Land Management or by a decree of a Court of Law and/or that the corner points mentioned in lines 3, 4 and 5 above were in conformance with the rules of the Michigan Board of Land Surveyors or by a Decree of a Court of Law; established, re-established, monumented, re-monumented, recovered, found as expressed below:

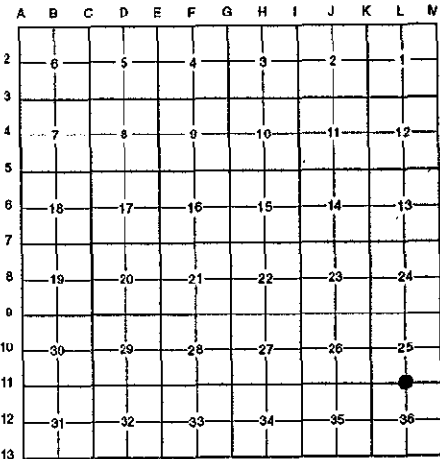

NOTE: Not more than 4 corners, all in the same town and range, may be recorded on this certificate.

A. Description of original monument and accessories and/or subsequent restoration:

L-11	1831	G.L.O. Notes	Mullett	Set Post
	N/A	Notes	Williams & Works	1/2" Iron
	1933	Witness Map	K.C. Surveyor	2" Stake
	1971	L.C.R.C. #60	Williams & Works	"T" Iron
	1981	L.C.R.C. #2600	Jonker Land Surveys	Fnd. "T" Iron / Set K.C. Monument
	1994	L.C.R.C. #8102	Glaza & Associates	K.C. Monument

P.A. 345 1990 KENT COUNTY  
PEER APPROVED 5/22/97  
CHAIRMAN Harry Kabeer

This corner was originally approved by the Kent County Remonumentation Peer Group and monumented by Rob Jonker on 12/11/81 and was recorded per L.C.R.C. #2600.

B. Description of corner evidence found and/or method applied in restoring or reestablishing corner:

L-11 Found a Standard Kent County Monument 3' ± South of the C/L of Vergennes Street (bit) running East and West on line of a tree row and fence line running South per L.C.R.C.'s #2600 and #8102 as set by Rob Jonker in place of a "T" iron he found at grade over a 1" iron in a concrete block 12" below grade which checked L.C.R.C. #60, Williams & Works notes, and the K.C. Surveyor's records.

L.C.R.C. #2600

L.C.R.C. #8102

Remon. tag on W side p. pole N 05° W 61.13'  
Remon. tag on SE side 18" Oak N 66° E 61.51'  
Remon. tag on NE side 28" Oak S 58° E 68.10'  
Remon. tag on NE side 28" Oak S 28° E 43.52'  
Remon. tag on NW side 24" Oak S 50° W 46.30'

K.C. remon. tag & nail in West side P. pole N 05° W 61.13' (61.15')  
K.C. remon. tag & nail in SE side 20" Oak N 66° E 61.66' (61.67')  
K.C. remon. tag & nail in NE side 30" Oak S 58° E 68.07' (68.05')  
K.C. remon. tag & nail in NE side 30" Oak S 28° E 43.52' (43.54')  
K.C. remon. tag & nail in NW side 26" Oak S 50° W 46.35' (46.36')  
Center line pavement, South 3' ±  
In line with edge of woods to the South

The selected location is accepted by me and is generally accepted by professional surveyors as the best available evidence of the position of the original corner.

C. Description of monument for corner and accessories established to perpetuate locating the position of the corner:

L-11 Standard Kent County Monument

Nail & K.C. remon. tag on W side P. pole N 05° W 61.15'  
Nail & K.C. remon. tag on SE side 20" Oak N 66° E 61.67'  
Nail & K.C. remon. tag on NE side 30" Oak S 58° E 68.05'  
Nail & K.C. remon. tag on NE side 30" Oak S 28° E 43.54'  
Nail & K.C. remon. tag on NW side 26" Oak S 50° W 46.36'

Signed by Randy J. Kolehouse Date 8-1-97  
EARTH TECH

Surveyor's Michigan License No. 25854

