

SURVEY & REMONUMENTATION

MAR 03 1998

LAND CORNER RECORDATION CERTIFICATE
 Filing Requirement of Act 74, Mich. P.A. 1970
 KENT COUNTY REMONUMENTATION

For corners in **SECTION**
Kent
 (County)

Located in: Ada Township Corner Code #


1. Public Land Survey T 7N R 10W M-4
 T _____ R _____
 T _____ R _____
 T _____ R _____
2. Property Controlling in Section S _____ T _____ R _____
 S _____ T _____ R _____
3. Miscellaneous Property in Sec. S _____ T _____ R _____
 S _____ T _____ R _____
4. Lot No. _____, Recorded Plat _____
5. Private Claims _____

STATE OF MICHIGAN
 COUNTY OF KENT
 RECEIVED FOR RECORD
 97 NOV 14 AM 9:01
 REG. OF DEEDS
David Standa

10318

Register of Deeds Stamp & File Number

I, Randy Kolehouse, in a field survey on August 11 19 97, do hereby certify that under requirements of P.A. 74 Michigan P.A. of 1970, the corner points mentioned in lines 1 and 2 above were in conformance with regulations and rules therefore as required in the current manual of survey instructions of the United States Department of the Interior, Bureau of Land Management or by a decree of a Court of Law and/or that the corner points mentioned in lines 3, 4 and 5 above were in conformance with the rules of the Michigan Board of Land Surveyors or by a Decree of a Court of Law; established, re-established, monumented, re-monumented, recovered, found as expressed below:

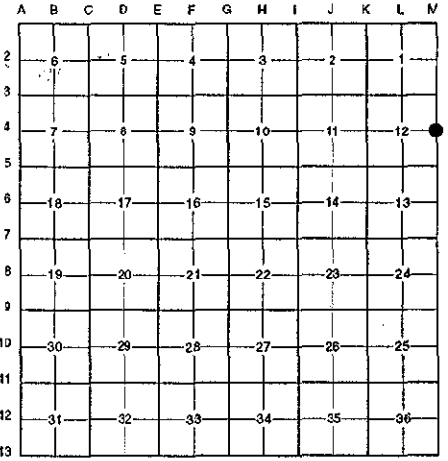

NOTE: Not more than 4 corners, all in the same town and range, may be recorded on this certificate.

A. Description of original monument and accessories and/or subsequent restoration:

M-4	1831	G.L.O. Notes	Mullett	Set Post
	N/A	Records	Consumers Power Co.	Plow Point
	1984	L.C.R.C. #3868	M. Rosema	Fnd. Plow Point / Set K.C. Monument
	1991	L.C.R.C. #5820	Exxel Engineering	K.C. Monument
	1995	L.C.R.C. #8049	Glaza & Associates	K.C. Monument

Note: This corner is common with A-4, T7N, R9W.

This corner was originally approved by the Kent County Remonumentation Peer Group and monumented by M. Rosema on 7/23/84 and was recorded per L.C.R.C. #3868.

B. Description of corner evidence found and/or method applied in restoring or reestablishing corner:

M-4 Found a Standard Kent County Monument on trace of a fence line running North, South East and West, 6' ± Southeast of a small creek (dried up), 1' South of a steel fence post, and 250 ± East of the C/L of high voltage power lines per L.C.R.C.'s #3868, #5820 and #8049 as set by M. Rosema in place of a plow point he found which checked Consumers Power Company records.

L.C.R.C. #3868

L.C.R.C. #8049

- Nail and remon tag in W side of 6" Basswood - S 26°E 18.98'
- Nail and remon tag in S side 15" Basswood - S 45°W 32.39'
- Nail and remon tag in N side 18" Maple - S 77°W 31.83'
- Nail and remon tag in SW side 8" Basswood - N 56°W 18.87'
- Nail and remon tag in N side 15" Maple - N 89°E 33.40'


- Nail & K.C. remon tg in W side 10" Basswood S21°E 18.98'
- Nail & K.C. remon tag in S side 22" Basswood S48°W 32.41' (m. 32.44)
- Nail & K.C. remon tag in N side 22" Maple S80°W 31.83'
- Nail & K.C. remon tag in SW side 12" Basswood N53°W 18.84'
- Nail & K.C. remon tag in N side 18" Maple N89°E 33.43'
- Steel fence post 1' North

The selected location is accepted by me and is generally accepted by professional surveyors as the best available evidence of the position of the original corner.

C. Description of monument for corner and accessories established to perpetuate locating the position of the corner:

M-4 Standard Kent County Monument

- Nail & K.C. remon. tag on W side 10" Basswood S 21° E 18.98'
- Nail & K.C. remon. tag on S side 22" Basswood S 48° W 32.44'
- Nail & K.C. remon. tag on N side 22" Maple S 80° W 31.83'
- Nail & K.C. remon. tag on SW side 12" Basswood N 53° W 18.84'
- Nail & K.C. remon. tag on N side 18" Maple N 89° E 33.43'

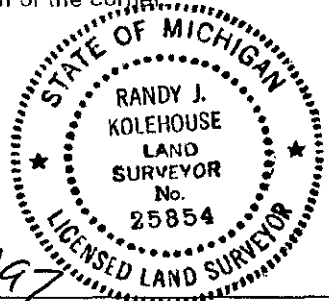

Signed by Randy J. Kolehouse
 EARTH TECH

Date 9/23/97

Surveyor's Michigan License No. 25854