

**SURVEY & REMONUMENTATION**

MAR 03 1998

**SECTION**


**LAND CORNER RECORDATION CERTIFICATE**  
**Filing Requirement of Act 74, Mich. P.A. 1970**  
**KENT COUNTY REMONUMENTATION**

For corners in

<u>Kent</u> (County)	Located in: <u>Ada</u> Township	Corner Code # <u>M-5</u>
1. Public Land Survey	T <u>7N</u> R <u>10W</u>	<u>M-5</u>
	T _____ R _____	_____
	T _____ R _____	_____
	T _____ R _____	_____
2. Property Controlling in Section	S _____ T _____ R _____	_____
	S _____ T _____ R _____	_____
3. Miscellaneous Property in Sec.	S _____ T _____ R _____	_____
	S _____ T _____ R _____	_____
4. Lot No. _____, Recorded Plat _____		
5. Private Claims _____		

STATE OF MICHIGAN  
 COUNTY OF KENT  
 RECEIVED FOR RECORD  
 97 OCT 15 AM 8:52  
 REG. OF DEEDS  
 10247  
 Register of Deeds Stamp & File Number

I, Randy Kolehouse, in a field survey on June 3 19 97, do hereby certify that under requirements of P.A. 74 Michigan P.A. of 1970, the corner points mentioned in lines 1 and 2 above were in conformance with regulations and rules therefore as required in the current manual of survey instructions of the United States Department of the Interior, Bureau of Land Management or by a decree of a Court of Law and/or that the corner points mentioned in lines 3, 4 and 5 above were in conformance with the rules of the Michigan Board of Land Surveyors or by a Decree of a Court of Law; established, re-established, monumented, re-monumented, recovered, found as expressed below:

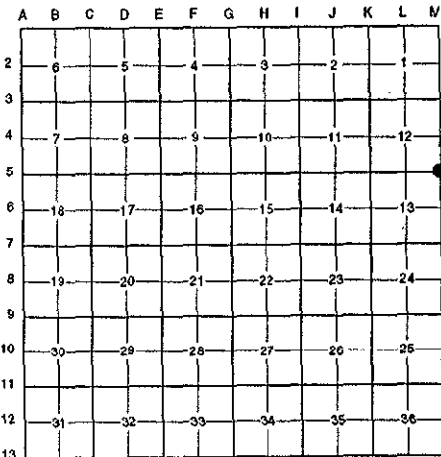

**NOTE: Not more than 4 corners, all in the same town and range, may be recorded on this certificate.**

**A. Description of original monument and accessories and/or subsequent restoration:**

M-5	1831	G.L.O. Notes	Mullett	Set Post
	1938	Witness Map	K.C. Surveyor	Stone
	1961	Witness Map	K.C. Surveyor	Stone
	1972	L.C.R.C. #465	Williams & Works	"T" Iron
	1981	L.C.R.C. #1916	Jonker Land Surveys	Fnd. "T" Iron / Set K.C. Monument
	1991	L.C.R.C. #5821	Exxel Engineering	K.C. Monument
	1994	L.C.R.C. #8050	Glaza & Associates	K.C. Monument

P.A. 345 1990 KENT COUNTY  
 PEER APPROVED 6/26/97  
 CHAIRMAN Harry Huber

Note: This corner is common with A-5, T7N, R9W.

This corner was originally approved by the Kent County Remonumentation Peer Group and monumented by Rob Jonker on 7/16/81 and was recorded per L.C.R.C. #1916.

**B. Description of corner evidence found and/or method applied in restoring or reestablishing corner:**

M-5 Found a Standard Kent County Monument 6.5' North of the C/L of 2 Mile Road (bit.) running East and West per L.C.R.C.'s #1916, #5821 and #8050 as set by Rob Jonker in place of a "T" iron he found over a 3/4" rd. iron 24" below grade which checked L.C.R.C. #465 and the K.C. Surveyor's records.

L.C.R.C. #1916

L.C.R.C. #8050

Remon. tag on NE side 24" Maple S 53° E 74.98'  
 Remon. tag on E side 14" Maple S 02° W 58.58'  
 Remon. tag on N side fe. post N 54° E 45.43'


K.C. remon tag & nail in E side 16" Maple S 05° W 58.88'  
 K.C. remon tag & nail in N side fence post N 59° E 45.44'  
 K.C. remon tag & nail in NE side 18" Ash S 39° E 91.43'  
 K.C. remon tag & nail in E side 8" Elm N 22° E 22.50'

The selected location is accepted by me and is generally accepted by professional surveyors as the best available evidence of the position of the original corner.

**C. Description of monument for corner and accessories established to perpetuate locating the position of the corner:**

M-5 Standard Kent County Monument

Nail & K.C. remon. tag on NW side 16" Maple S 05° W 58.88'  
 Nail & K.C. remon. tag on N side fence post N 59° E 45.44'  
 Nail & K.C. remon. tag on NE side 18" Ash S 39° E 91.43'  
 Nail & K.C. remon. tag on E side 8" Elm N 22° E 22.50'

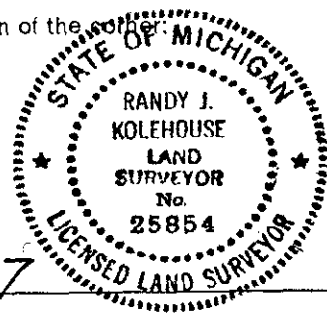

Signed by Randy J. Kolehouse Date 8-1-97  
 EARTH TECH  
 Surveyor's Michigan License No. 25854