

SURVEY & REMONUMENTATION

MAR 03 1998

LAND CORNER RECORDATION CERTIFICATE
Filing Requirement of Act 74, Mich. P.A. 1970
KENT COUNTY REMONUMENTATION

For corners in SECTION
Kent
 (County)

Located in: Ada Corner Code #
 Township

- | | | | |
|------------------------------------|-------------|--------------|------------|
| 1. Public Land Survey | T <u>7N</u> | R <u>10W</u> | <u>M-7</u> |
| | T _____ | R _____ | _____ |
| | T _____ | R _____ | _____ |
| | T _____ | R _____ | _____ |
| 2. Property Controlling in Section | S _____ | T _____ | R _____ |
| | S _____ | T _____ | R _____ |
| 3. Miscellaneous Property in Sec. | S _____ | T _____ | R _____ |
| | S _____ | T _____ | R _____ |

4. Lot No. _____, Recorded Plat _____
 5. Private Claims _____

STATE OF MICHIGAN
 COUNTY OF KENT
 RECEIVED FOR RECORD
 97 OCT 15 AM 8:52
 REG. OF DEEDS
Eric Strand
10249

Register of Deeds Stamp & File Number

I, Randy Kolehouse, in a field survey on July 15, 1997 19 97, do hereby certify that under requirements of P.A. 74 Michigan P.A. of 1970, the corner points mentioned in lines 1 and 2 above were in conformance with regulations and rules therefore as required in the current manual of survey instructions of the United States Department of the Interior, Bureau of Land Management or by a decree of a Court of Law and/or that the corner points mentioned in lines 3, 4 and 5 above were in conformance with the rules of the Michigan Board of Land Surveyors or by a Decree of a Court of Law; established, re-established, monumented, re-monumented, recovered, found as expressed below:

NOTE: Not more than 4 corners, all in the same town and range, may be recorded on this certificate.

A. Description of original monument and accessories and/or subsequent restoration:

M-7	1831	G.L.O. Notes	Mullett	Set Post
	1956	Witness Map	K.C. Surveyor	Iron
	1975	L.C.R.C. #800	Moore & Bruggink	Iron
	1977	L.C.R.C. #974	Exxel Engineering	1/2" Iron (A-7, T7N, R9W)
	1981	L.C.R.C. #1918	Jonker Land Surveys	Fnd. 3/4" Rd. Iron / Set K.C. Monument
	1991	L.C.R.C. #5823	Exxel Engineering	K.C. Monument
	1995	L.C.R.C. #8052	Glaza & Associates	K.C. Monument

Note: This corner is common with A-7, T7N, R9W.

This corner was originally approved by the Kent County Remonumentation Peer Group and monumented by Rob Jonker on 7/14/81 and was recorded per L.C.R.C. #1918.

B. Description of corner evidence found and/or method applied in restoring or reestablishing corner:

M-7 Found a Standard Kent County Monument at the fence post on the corner of a fence line running North and East per L.C.R.C.'s #1918, #5823 and #8052 as set by Rob Jonker in place of a 3/4" round iron he found which checked L.C.R.C.'s #974, #800 and the K.C. Surveyor's records.

L.C.R.C. #1918

L.C.R.C. #8052

- Remon. tag on S side 8" Oak N 66° E 8.98'
- Remon. tag on E side 14" Oak S 14° E 12.47'
- Remon. tag on W side 15" Oak N 07° E 18.46'
- Remon. tag on S side 9" W. Ch. S 47° W 33.97'
- Remon. tag on SW side 10" Tw. W. Ch. N 33° W 25.95'

- Nail & K.C. remon tag in S side 10" Oak N 71° E 9.09'
- Nail & K.C. remon tag in E side 18" Oak S 15° W 12.78'
- Nail & K.C. remon. tag in W side 18" Oak N 02° E 18.42'
- Nail & K.C. remon tag in SW side 14" Twin W. Cherry N 34° W 25.90'
- Nail & K.C. remon tag in S side 9" W. Cherry (dead) S 44° W 33.87'

The selected location is accepted by me and is generally accepted by professional surveyors as the best available evidence of the position of the original corner.


C. Description of monument for corner and accessories established to perpetuate locating the position of the corner:

M-7 Standard Kent County Monument

- Nail & K.C. remon. tag on S side 10" Oak N 71° E 9.09'
- Nail & K.C. remon. tag on E side 18" Oak S 15° W 12.78'
- Nail & K.C. remon. tag on W side 18" Oak N 02° E 18.92'
- Nail & K.C. remon. tag on SW side 16" Twin Cherry N 34° W 25.90'

Signed by *Randy J. Kolehouse* Date 8-1-97
 EARTH TECH

Surveyor's Michigan License No. 25854

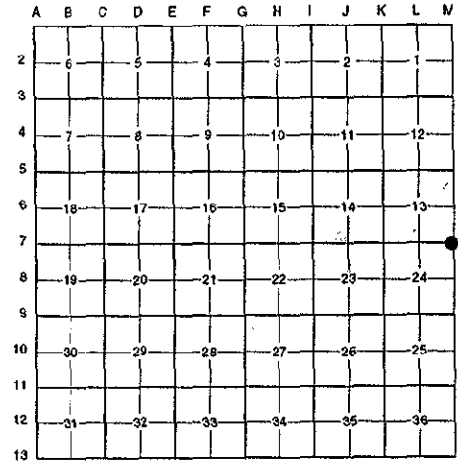

P.A. 345 1990 KENT COUNTY
 PEER APPROVED 7/24/97
 CHAIRMAN *Randy Kolehouse*

