SURVEY & REMONUMENTATION

MAR 0 3 1998

STATE OF MICHIGAN
COUNTY OF KENT
RECEIVED FOR RECORD
97 OCT 15 AM 8:52
REG. OF DEEDS

10250

Register of Deeds Stamp & File Number

LAND CORNER RECORDATION CERTIFICATE
Filing Requirement of Act 74, Mich. P.A. 1970
KENT COUNTY REMONUMENTATION

For corners in SECTION

Kent (County) Located in: Ada Township Corner Code #

1. Public Land Survey T 7N R 10W M-8
2. Property Controlling in Section
3. Miscellaneous Property in Sec.

4. Lot No._____, Recorded Plat _____
5. Private Claims _____

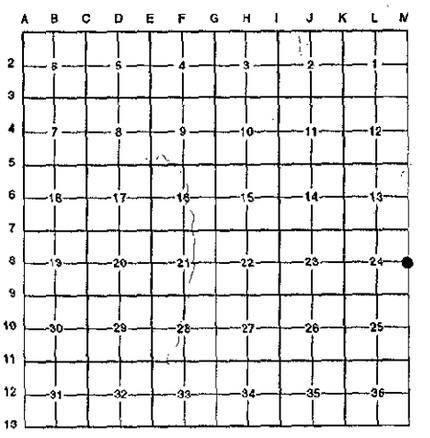

I, Randy Kolehouse, in a field survey on June 3 19 97, do hereby certify that under requirements of P.A. 74 Michigan P.A. of 1970, the corner points mentioned in lines 1 and 2 above were in conformance with regulations and rules therefore as required in the current manual of survey instructions of the United States Department of the interior, Bureau of Land Management or by a decree of a Court of Law and/or that the corner points mentioned in lines 3, 4 and 5 above were in conformance with the rules of the Michigan Board of Land Surveyors or by a Decree of a Court of Law; established, re-established, monumented, re-monumented, recovered, found as expressed below:

NOTE: Not more than 4 corners, all in the same town and range, may be recorded on this certificate.

A. Description of original monument and accessories and/or subsequent restoration:

M-8	1831	G.L.O. Notes	Mullett	Set Post
	1956	Witness Map	K.C. Surveyor	Iron
	1975	L.C.R.C. #800	Moore & Bruggink	Iron
	1977	L.C.R.C. #974	Moore & Bruggink	3/4" Iron (A-8, T7N, R9W)
	1981	L.C.R.C. #1919	Jonker Land Surveys	Fnd. 3/4" Iron / Set K.C. Monument
	1991	L.C.R.C. #5824	Exxel Engineering	K.C. Monument
	1994	L.C.R.C. #8053	Glaza & Associates	K.C. Monument

Note: This corner is common with A-8, T7N, R9W.

P.A. 345 1990 KENT COUNTY
PEER APPROVED 6/26/97
CHAIRMAN

This corner was originally approved by the Kent County Remonumentation Peer Group and monumented by Rob Jonker on 7/17/81 and was recorded per L.C.R.C. #1919.

B. Description of corner evidence found and/or method applied in restoring or reestablishing corner:

M-8 Found a Standard Kent County Monument 2' ± North of the C/L of Mc Cabe Avenue (gravel) running East and West, 5' ± West of old fence row running North, and 180' ± East of the C/L of a bituminous drive running North to house #9575 per L.C.R.C.'s #1919, #5824, and #8053 as set by Rob Jonker in place of a 3/4" iron he found which checked L.C.R.C.'s #974, #800 and the K.C. Surveyor's records.

L.C.R.C. #1919	L.C.R.C. #8053
Remon. tag on SE side 15" Cherry N 37° E 39.08'	Nail & K.C. remon tag in SE side 18" Cherry N 38° E 39.08'
Remon. tag on NE side 16" Oak S 33° E 35.18'	Nail & K.C. remon tag in NE side 18" Oak S 34° E 35.21' (m. 35.27')
Remon. tag on NE side 36" Oak N 22° W 36.00'	Nail & K.C. remon tag in NE side 38" Oak N 20° W 35.26' (m. 35.30')
Remon. tag on SW side 12" Cherry S 55° E 43.69'	Nail & K.C. remon tag in SW side 12" Cherry S 54° E 43.73' (m. 43.77')

The selected location is accepted by me and is generally accepted by professional surveyors as the best available evidence of the position of the original corner.

C. Description of monument for corner and accessories established to perpetuate locating the position of the corner:

M-8 Standard Kent County Monument

Nail & K.C. remon. tag on SE side 18" Cherry N 38° E 39.08'
Nail & K.C. remon. tag on NE side 18" Oak S 34° E 35.27'
Nail & K.C. remon. tag on NE side 38" Oak N 20° W 35.30'
Nail & K.C. remon. tag on SW side 12" Cherry S 54° E 43.77'

STATE OF MICHIGAN
RANDY J. KOLEHOUSE
LAND SURVEYOR
No. 25854
LICENSED LAND SURVEYOR

Signed by Randy J. Kolehouse Date 8-1-97
EARTH TECH

Surveyor's Michigan License No. 25854

FORM APPROVED BY MICHIGAN STATE BOARD OF LAND SURVEYORS, JAN. 26, 1971
REVISED MAY 14, 1975
REVISED JAN., 1983