

**SURVEY & REMONUMENTATION**

MAR 03 1998

**SECTION**

**LAND CORNER RECORDATION CERTIFICATE**  
 Filing Requirement of Act 74, Mich. P.A. 1970  
 KENT COUNTY REMONUMENTATION

For corners in

Kent (County)	Located in: Ada Township	Corner Code #
1. Public Land Survey	T <u>7N</u> R <u>10W</u>	<u>M-10</u>
	T _____ R _____	_____
	T _____ R _____	_____
	T _____ R _____	_____
2. Property Controlling in Section	S _____ T _____ R _____	_____
	S _____ T _____ R _____	_____
3. Miscellaneous Property in Sec.	S _____ T _____ R _____	_____
	S _____ T _____ R _____	_____


STATE OF MICHIGAN  
 COUNTY OF KENT  
 RECEIVED FOR RECORD  
 97 OCT 15 AM 8:52  
 REG. OF DEEDS  
*Lucy St. Paul*

10252

Register of Deeds Stamp & File Number

4. Lot No. \_\_\_\_\_, Recorded Plat \_\_\_\_\_  
 5. Private Claims \_\_\_\_\_

I, Randy Kolehouse, in a field survey on January 29 19 97, do hereby certify that under requirements of P.A. 74 Michigan P.A. of 1970, the corner points mentioned in lines 1 and 2 above were in conformance with regulations and rules therefore as required in the current manual of survey instructions of the United States Department of the Interior, Bureau of Land Management or by a decree of a Court of Law and/or that the corner points mentioned in lines 3, 4 and 5 above were in conformance with the rules of the Michigan Board of Land Surveyors or by a Decree of a Court of Law; established, re-established, monumented, re-monumented, recovered, found as expressed below:

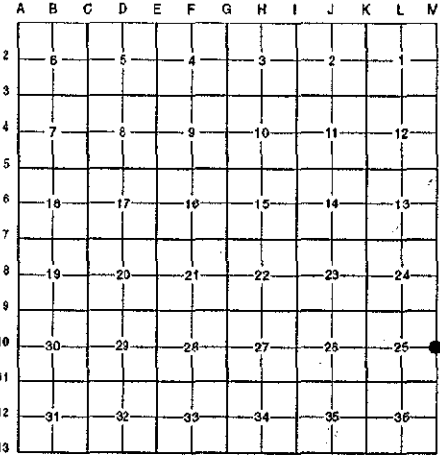

**NOTE: Not more than 4 corners, all in the same town and range, may be recorded on this certificate.**

**A. Description of original monument and accessories and/or subsequent restoration:**

M-10 1831	G.L.O. Notes	Mullett	Set Post
1944	Witness Map	K.C. Surveyor	Concrete Monument
1975	L.C.R.C. #916	McCombs	1" Pipe (A-10, T7N, R9W)
1977	L.C.R.C. #1022	Williams & Works	Concrete Monument
1981	L.C.R.C. #1921	Jonker Land Surveys	Fnd. 1" Iron in Conc. Mon. / Set K.C. Monument
1991	L.C.R.C. #5826	Exxel Engineering	K.C. Monument
1994	L.C.R.C. #8055	Glaza & Associates	K.C. Monument

P.A. 345 1990 KENT COUNTY

PEER APPROVED 5/22/97  
 CHAIRMAN Randy Kolehouse

Note: This corner is common with A-10, T7N, R9W.

This corner was originally approved by the Kent County Remonumentation Peer Group and monumented by Rob Jonker and was recorded per L.C.R.C. #1921.

**B. Description of corner evidence found and/or method applied in restoring or reestablishing corner:**

M-10 Found a Standard Kent County Monument in the C/L of Boynton Avenue (gravel) running North and South and 35' ± South of a farm road running East separating two fields per L.C.R.C.'s #1921, #5826 and #8055 as set by Rob Jonker in place of a 1" iron he found in a concrete monument which checked L.C.R.C. #1022, #916, and the K.C. Surveyor's records.

L.C.R.C. #1921

L.C.R.C. #8055

Remon. tag on SE side 20" Oak S 59° W 27.80'  
 Remon. tag on S side 17" Oak N 90° W 34.30'  
 Remon. tag on NE side 10" Oak N 20° W 55.03'  
 On C/L N-S gravel road


Nail & K.C. remon. tag in SE side 22" Oak S 57° W 27.82' (27.83')  
 Nail & K.C. remon. tag in S side 20" Oak S 88° W 34.34' (34.35')  
 Nail & K.C. remon. tag in S side 14" Oak N 67° W 34.46' (34.47')  
 Nail & K.C. remon. tag in N side 18" Twin Maple S 47° E 35.17'  
 Nail & K.C. remon. tag in NE side 12" Oak N 20° W 55.10' (55.08')  
 On C/L N-S gravel road

The selected location is accepted by me and is generally accepted by professional surveyors as the best available evidence of the position of the original corner.

**C. Description of monument for corner and accessories established to perpetuate locating the position of the corner:**

M-10 Standard Kent County Monument

Nail & K.C. remon. tag on SE side 22" Oak S 57° W 27.83'  
 Nail & K.C. remon. tag on S side 20" Oak S 88° W 34.35'  
 Nail & K.C. remon. tag on S side 14" Oak N 67° W 34.47'  
 Nail & K.C. remon. tag on N side 18" Twin Maple S 47° E 35.17'  
 Nail & K.C. remon. tag on NE side 12" Oak N 20° W 55.08'

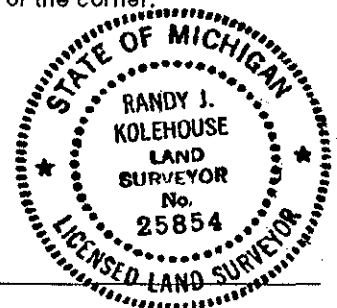

Signed by Randy J. Kolehouse Date 8-1-97  
 EARTH TECH

Surveyor's Michigan License No. 25854