

SURVEY & REMONUMENTATION

MAR 03 1998

LAND CORNER RECORDATION CERTIFICATE
Filing Requirement of Act 74, Mich. P.A. 1970
KENT COUNTY REMONUMENTATION

For corners in SECTION
Kent
 (County)

Located in: Ada Corner Code #
 Township

- | | | |
|------------------------------------|--------------------------|-------------|
| 1. Public Land Survey | T <u>7N</u> R <u>10W</u> | <u>M-11</u> |
| | T _____ R _____ | _____ |
| | T _____ R _____ | _____ |
| | T _____ R _____ | _____ |
| 2. Property Controlling in Section | S _____ T _____ R _____ | _____ |
| | S _____ T _____ R _____ | _____ |
| 3. Miscellaneous Property in Sec. | S _____ T _____ R _____ | _____ |
| | S _____ T _____ R _____ | _____ |

4. Lot No. _____, Recorded Plat _____
 5. Private Claims _____

REG. OF DEEDS

Lucy Bond


97 OCT 15 AM 8:52

STATE OF MICHIGAN
 COUNTY OF KENT
 RECEIVED FOR RECORD

10253

Register of Deeds Stamp & File Number

I, Randy Kolehuse, in a field survey on January 29 19 97, do hereby certify that under requirements of P.A. 74 Michigan P.A. of 1970, the corner points mentioned in lines 1 and 2 above were in conformance with regulations and rules therefore as required in the current manual of survey instructions of the United States Department of the interior, Bureau of Land Management or by a decree of a Court of Law and/or that the corner points mentioned in lines 3, 4 and 5 above were in conformance with the rules of the Michigan Board of Land Surveyors or by a Decree of a Court of Law; established, re-established, monumented, re-monumented, recovered, found as expressed below:

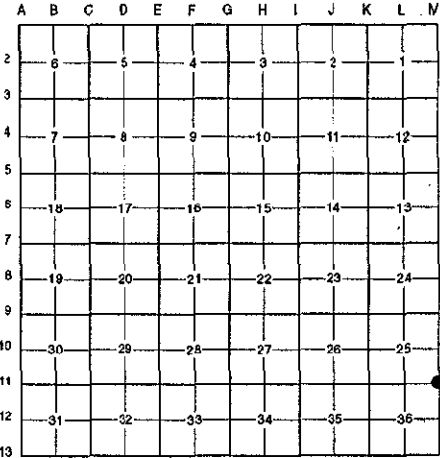

NOTE: Not more than 4 corners, all in the same town and range, may be recorded on this certificate.

A. Description of original monument and accessories and/or subsequent restoration:

M-11 1831	G.L.O. Notes	Mullett	Set Post
1932-56	Witness Map	K.C. Surveyor	Iron
1972	L.C.R.C. #245	Williams & Works	Boat Spike
1975	L.C.R.C. #919	McCombs	Boat Spike (A-11, T7N, R9W)
1981	L.C.R.C. #1922	Jonker Land Surveys	Fnd. Boat Spike & Iron / Set K.C. Monument
1991	L.C.R.C. #5827	Exxel Engineering	K.C. Monument
1994	L.C.R.C. #8056	Glaza & Associates	K.C. Monument

P.A. 345 1990 KENT COUNTY
 PEER APPROVED 5/22/97
 CHAIRMAN Randy Kolehuse

Note: This corner is common with A-11, T7N, R9W.

This corner was originally approved by the Kent County Remonumentation Peer Group and monumented by Rob Jonker and was recorded per L.C.R.C. #1922.

B. Description of corner evidence found and/or method applied in restoring or reestablishing corner:

M-11 Found a Standard Kent County Monument at the intersection of Vergennes Street (bit.) running East and West and Boynton Avenue running North and South per L.C.R.C.'s #1922, #5827 and #8056 as set by Rob Jonker in place of a boat spike he found at grade over a 3/4" iron 1' below grade which checked L.C.R.C.'s #919, #245, and the K.C. Surveyor's records.

L.C.R.C. #1922

L.C.R.C. #8056

Remon. tag on E side P. Pole N 31° E 68.89'
 Remon. tag on NW side T. pole S 38° W 51.20'
 Remon. tag on S side t. pole S 69° W 105.43"
 Remon. tag on N side 12" Oak S 74° E 141.09'
 SE corner school N 43° W 115.2'
 C/L pavement S 3' m/l


K.C. remon tag & nail in E side P. pole N 31° E 68.03'
 K.C. remon tag & nail in S side T. pole S 67° W 104.88' (104.89')
 K.C. remon tag & nail in N side 14" Oak S 74° E 140.78' (140.76')
 K.C. remon tag & nail in NW side 14" Oak N 43° W 115.20'
 SE corner of school
 On C/L pavement

The selected location is accepted by me and is generally accepted by professional surveyors as the best available evidence of the position of the original corner.

C. Description of monument for corner and accessories established to perpetuate locating the position of the corner:

M-11 Standard Kent County Monument

- Nail & K.C. remon. tag on E side P. pole N 30° E 68.03'
- Nail & K.C. remon. tag on S side T. pole S 67° W 104.89'
- Nail & K.C. remon. tag on N side 14" Oak S 74° E 140.76'
- Nail & K.C. remon. tag on NW side 14" Oak S 38° W 54.77'
- SE cor. school N 43° W 115.20'

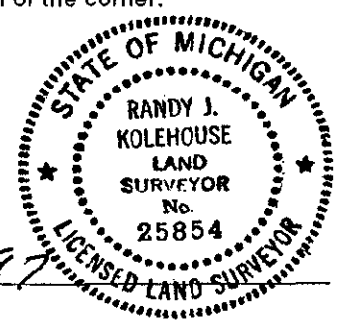

Signed by Randy J. Kolehuse Date 8-1-97
 EARTH TECH

Surveyor's Michigan License No. 25854