

SURVEY & REMONUMENTATION

MAR 03 1998

\$7.00
\$2.00

SECTION

LAND CORNER RECORDATION CERTIFICATE
Filing Requirement of Act 74, Mich. P.A. 1970
KENT COUNTY REMONUMENTATION

For corners in

Kent (County)	Located in:	Ada Township	Corner Code #
1. Public Land Survey	T _____ R _____		C-7
	T _____ R _____		
	T _____ R _____		
	T _____ R _____		
2. Property Controlling in Section	S _____ T <u>7N</u> R <u>10W</u>		1872.69' West of D-7
	S _____ T _____ R _____		
3. Miscellaneous Property in Sec.	S _____ T _____ R _____		
	S _____ T _____ R _____		

4. Lot No. _____, Recorded Plat _____
5. Private Claims _____

I, Randy Kolehouse, in a field survey on November 14 19 97, do hereby certify that under requirements of P.A. 74 Michigan P.A. of 1970, the corner points mentioned in lines 1 and 2 above were in conformance with regulations and rules therefore as required in the current manual of survey instructions of the United States Department of the interior, Bureau of Land Management or by a decree of a Court of Law and/or that the corner points mentioned in lines 3, 4 and 5 above were in conformance with the rules of the Michigan Board of Land Surveyors or by a Decree of a Court of Law; established, re-established, monumented, re-monumented, recovered, found as expressed below:

NOTE: Not more than 4 corners, all in the same town and range, may be recorded on this certificate.

A. Description of original monument and accessories and/or subsequent restoration:

C-7 1831 G.L.O. Notes Mullett Set Post
1988 L.C.R.C. #4941 Exxel Engineering Set Witness Corners

This corner was originally approved by the Kent County Remonumentation Peer Group and monumented by Exxel Engineering on 2/11/88 and was recorded per L.C.R.C. #4941.

B. Description of corner evidence found and/or method applied in restoring or reestablishing corner:

C-7 Found a Standard Kent County Monument 4' East of T.B. of Grand River per L.C.R.C. #4941 as set by Exxel Engineering.

L.C.R.C. #4941

- Nail & tag NW sde 16" Ash N 55° E 35.56' (m. 31.50')
- Nail & tag S sde 16" Ash S 80° E 31.50' (m. 35.56')
- Nail & tag E sde 12" Ash N 0° E 35.47'
- Nail & tag NE sde 12" Ash N 40° W 40.09'
- T.B. along river SW 4'


The selected location is accepted by me and is generally accepted by professional surveyors as the best available evidence of the position of the original corner.

C. Description of monument for corner and accessories established to perpetuate locating the position of the corner:

- C-7 Standard Kent County Monument
- Nail & K.C. remon. tag on NW side 16" Ash N 55° E 31.50'
 - Nail & K.C. remon. tag on S side 16" Ash S 80° E 35.56'
 - Nail & K.C. remon. tag on E side 12" Ash N 00° E 35.47'
 - Nail & K.C. remon. tag on NE side 12" Ash N 40° W 40.09'

STATE OF MICHIGAN
COUNTY OF KENT
RECEIVED FOR RECORD
97 DEC 15 AM 10:41
REG. OF DEEDS
Handwritten signature
Other code #17

10353
Register of Deeds Stamp & File Number

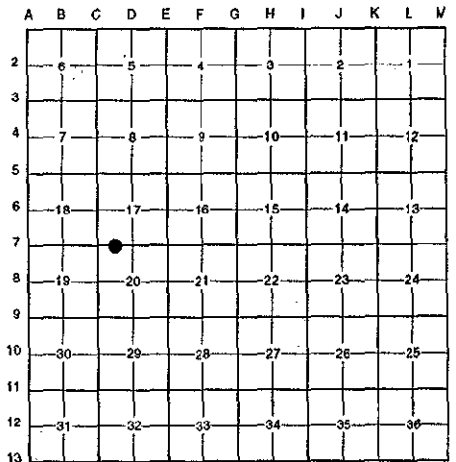

P.A. 345 1990 KENT COUNTY
PEER APPROVED 11/20/97
CHAIRMAN *Handwritten signature*

Signed by Randy J Kolehouse
EARTH TECH

Date 11/28/97

Surveyor's Michigan License No. 25854

