

JAN 24 1996

COMMISSION


LAND CORNER RECORDATION CERTIFICATE
Filing Requirement of Act 74, Mich. P.A. 1970
KENT COUNTY REMONUMENTATION

For corners in

Table with columns: Kent (County), Located in:, Corner Code #. Rows include Public Land Survey, Property Controlling in Section, and Miscellaneous Property in Sec.

STATE OF MICHIGAN
COUNTY OF KENT
RECEIVED FOR RECORD
95 DEC 28 PM 2:17
REG. OF DEEDS
8874
Register of Deeds Stamp & File Number

- 4. Lot No.
5. Private Claims

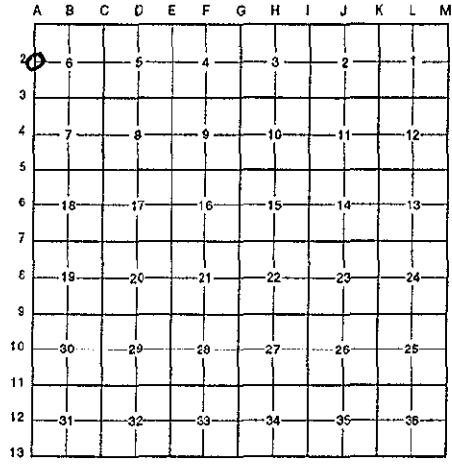

I, Randy Kolehouse, in a field survey on November 28 19 95, do hereby certify that under requirements of P.A. 74 Michigan P.A. of 1970, the corner points mentioned in lines 1 and 2 above were in conformance with regulations and rules therefore as required in the current manual of survey instructions of the United States Department of the interior, Bureau of Land Management or by a decree of a Court of Law and/or that the corner points mentioned in lines 3, 4 and 5 above were in conformance with the rules of the Michigan Board of Land Surveyors or by a Decree of a Court of Law; established, re-established, monumented, re-monumented, recovered, found as expressed below:

NOTE: Not more than 4 corners, all in the same town and range, may be recorded on this certificate.

A. Description of original monument and accessories and/or subsequent restoration:

A-2 This corner was not originally set by the G.L.O.

No information on record for this corner.

P.A. 345 1980 KENT COUNTY
PEER APPROVED 11/30/95
CHAIRMAN Randy Kolehouse

Note: This corner is not common with M-2, T7N, R12W.

B. Description of corner evidence found and/or method applied in restoring or reestablishing corner:

A-2 Set point on Township line between M-1 and M-2, T7N, R12W, at government dist. North of M-2 as measured at M-3, T7N, R12W and A-3, T7N, R11W (10.66 feet).


Measure South to A-3 = 2652.10' (G.L.O. = 2640.0')
Measure North to A-1 = 3008.9' (G.L.O. = 3036.0')

The selected location is accepted by me and is generally accepted by professional surveyors as the best available evidence of the position of the original corner.

C. Description of monument for corner and accessories established to perpetuate locating the position of the corner:

A-2 Set a standard 4" x 30" Kent County Monument. Corner falls in median of l-96.

- Nail & K.C. remon. tag in top of guard rail post S 45° W 60.91'
Nail & K.C. remon. tag in top of guard rail post S 02° W 33.88'
Nail & K.C. remon. tag in top of guard rail post S 70° E 174.74
Kent County Monument at M-2, T7N, R12W, South 10.66'

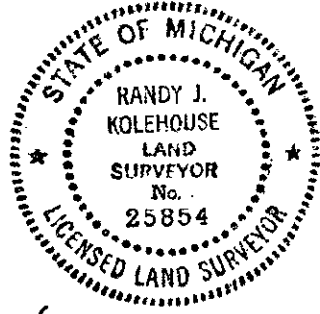

Signed by Randy J. Kolehouse Date 12/22/95
EARTH TECH

Surveyor's Michigan License No. 25854