

SURVEY & REMONUMENTATION

APR 28 1995

COMMISSION

LAND CORNER RECORDATION CERTIFICATE
 Filing Requirement of Act 74, Mich. P.A. 1970
 KENT COUNTY REMONUMENTATION

STATE OF MICHIGAN
 COUNTY OF KENT
 RECEIVED FOR RECORD

94 DEC -6 AM 8:59

For corners in

Kent (County)	Located in:	Corner Code #
1. Public Land Survey	T <u>7N</u> R <u>11W</u>	<u>A-5</u>
	T _____ R _____	_____
	T _____ R _____	_____
	T _____ R _____	_____
2. Property Controlling in Section	S _____ T _____ R _____	_____
	S _____ T _____ R _____	_____
3. Miscellaneous Property in Sec.	S _____ T _____ R _____	_____
	S _____ T _____ R _____	_____

W. J. Bond
 REG. OF DEEDS


7751

Register of Deeds Stamp & File Number

4. Lot No. _____, Recorded Plat _____
 5. Private Claims _____

I, Randy Kolehouse, in a field survey on July 1 19 94, do hereby certify that under requirements of P.A. 74 Michigan P.A. of 1970, the corner points mentioned in lines 1 and 2 above were in conformance with regulations and rules therefore as required in the current manual of survey instructions of the United States Department of the Interior, Bureau of Land Management or by a decree of a Court of Law and/or that the corner points mentioned in lines 3, 4 and 5 above were in conformance with the rules of the Michigan Board of Land Surveyors or by a Decree of a Court of Law; established, re-established, monumented, re-monumented, recovered, found as expressed below:

NOTE: Not more than 4 corners, all in the same town and range, may be recorded on this certificate.

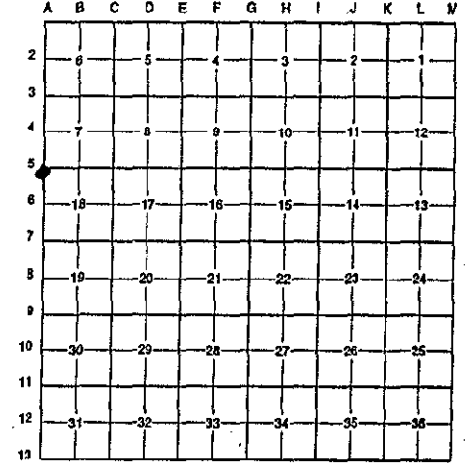

A. Description of original monument and accessories and/or subsequent restoration:

A-5	1831	G.L.O. Notes	L. Lyon	Set Post
	N/A	Survey Records	City of Grand Rapids	City Iron
	1985	L.C.R.C. #4230	Byl	Fnd. City Iron/Set K.C. Mon.

This corner was originally approved by the Kent County Remonumentation Peer Group and monumented by William R. Byl on 6/10/85 and was recorded per L.C.R.C. #4230.

B. Description of corner evidence found and/or method applied in restoring or reestablishing corner:

A-5 Found standard Kent County Monument per L.C.R.C. #4230 in the C/L of Knapp Street E-W 10.68' North of the SE corner, Section 12, T7N, R12W, as set by William Byl in place of a City iron he found which checked the City of Grand Rapids survey records and G.L.O. tie to Section 12, T7N, R12W.

L.C.R.C. #4230


- NW cor. fdn. extension hse. #5 N 40° E 101.80'
- SE cor. brick veneer hse. #3 N 00° E 63.05'
- NW cor. fdn. hse. #10 S 55° E 101.79'
- NE cor. porch fdn. hse. #4 S 15° W 48.08'
- NE cor. brick planter hse. #8 S 55° W 62.31'
- Kent County Monument at SE cor. Sec. 12 S 00° W 10.68'

P.A. 345 1990 KENT COUNTY
 PEER APPROVED 11/17/94
 CHAIRMAN Harry Huber

The selected location is accepted by me and is generally accepted by professional surveyors as the best available evidence of the position of the original corner.

C. Description of monument for corner and accessories established to perpetuate locating the position of the corner:

- A-5 Standard Kent County Monument
 - NW cor. fdn. extension hse. #5 N 40° E 101.80'
 - SE cor. brick veneer hse. #3 N 00° E 63.05'
 - NW cor. fdn. hse. #10 S 55° E 101.79'
 - NE cor. porch fdn. hse. #4 S 15° W 48.08'
 - NE cor. brick planter hse. #8 S 55° W 62.31'
 - Kent County Monument at SE cor. Sec. 12 S 00° W 10.68'

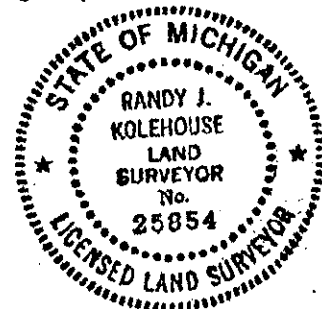

Signed by Randy J. Kolehouse Date 12/1/94
 Surveyor's Michigan License No. 25854