

# SURVEY & REMONUMENTATION

APR 28 1995

LAND CORNER RECORDATION CERTIFICATE  
Filing Requirement of Act 74, Mich. P.A. 1970  
KENT COUNTY REMONUMENTATION

STATE OF MICHIGAN  
COUNTY OF KENT  
RECEIVED FOR RECORD

94 DEC -6 AM 8:59

For corners in **COMMISSION**  
Kent  
(County)

Located In: Corner Code #

|                                    |   |    |   |     |     |
|------------------------------------|---|----|---|-----|-----|
| 1. Public Land Survey              | T | 7N | R | 11W | A-6 |
|                                    | T |    | R |     |     |
|                                    | T |    | R |     |     |
|                                    | T |    | R |     |     |
| 2. Property Controlling in Section | S |    | T | R   |     |
|                                    | S |    | T | R   |     |
| 3. Miscellaneous Property in Sec.  | S |    | T | R   |     |
|                                    | S |    | T | R   |     |

*W. J. Sand*  
REG. OF DEEDS

7759

Register of Deeds Stamp & File Number

4. Lot No. \_\_\_\_\_, Recorded Plat \_\_\_\_\_  
5. Private Claims \_\_\_\_\_

|    | A  | B  | C  | D  | E  | F  | G | H | I | J | K | L | M |
|----|----|----|----|----|----|----|---|---|---|---|---|---|---|
| 2  | 6  | 5  | 4  | 3  | 2  | 1  |   |   |   |   |   |   |   |
| 3  |    |    |    |    |    |    |   |   |   |   |   |   |   |
| 4  | 7  | 8  | 9  | 10 | 11 | 12 |   |   |   |   |   |   |   |
| 5  |    |    |    |    |    |    |   |   |   |   |   |   |   |
| 6  | 18 | 17 | 16 | 15 | 14 | 13 |   |   |   |   |   |   |   |
| 7  |    |    |    |    |    |    |   |   |   |   |   |   |   |
| 8  | 19 | 20 | 21 | 22 | 23 | 24 |   |   |   |   |   |   |   |
| 9  |    |    |    |    |    |    |   |   |   |   |   |   |   |
| 10 | 30 | 29 | 28 | 27 | 26 | 25 |   |   |   |   |   |   |   |
| 11 |    |    |    |    |    |    |   |   |   |   |   |   |   |
| 12 | 31 | 32 | 33 | 34 | 35 | 36 |   |   |   |   |   |   |   |
| 13 |    |    |    |    |    |    |   |   |   |   |   |   |   |

I, Randy Kolehouse, in a field survey on March 30, 19 94, do hereby certify that under requirements of P.A. 74, Michigan P.A. of 1970, the corner points mentioned in lines 1 and 2 above were in conformance with regulations and rules therefore as required in the current manual of survey instructions of the United States Department of the Interior, Bureau of Land Management or by a decree of a Court of Law and/or that the corner points mentioned in lines 3, 4 and 5 above were in conformance with the rules of the Michigan Board of Land Surveyors or by a Decree of a Court of Law; established, re-established, monumented, re-monumented, recovered, found as expressed below:

**NOTE: Not more than 4 corners, all in the same town and range, may be recorded on this certificate.**

A. Description of original monument and accessories and/or subsequent restoration:

A-6 This corner was not originally set by the G.L.O.

|           |                |                      |                              |
|-----------|----------------|----------------------|------------------------------|
| 1900-1940 | Survey Records | Williams & Works     | City Iron                    |
| N/A       | Survey Records | City of Grand Rapids | City Iron                    |
| 1985      | L.C.R.C. #4231 | William Byl          | Fnd. City Iron/Set K.C. Mon. |

The position of this corner was previously approved by the Kent County Remonumentation Peer Group and monumented by William Byl on 6/6/85 and was recorded per L.C.R.C. #4231.

B. Description of corner evidence found and/or method applied in restoring or reestablishing corner:

A-6 Found K.C. Monument per L.C.R.C. #4231 as set by William Byl in place of a City iron (2 x 12") that he found and checked with City of Grand Rapids and Williams & Works survey records.

L.C.R.C. #4231


- C/L top of City benchmark #106 S 40° W 40.77'
- C/L top of hyd. #6N 55° W 38.20'
- SW cor. bndn. hse. #5N 45° E 56.21'
- NW cor. conc. block bldg. 0.2' above walk S 45° E 48.96'
- Kent County Monument E 1/4 cor. Sec. 13 T7N R12W N 00° E 4.01'

P.A. 345 1990 KENT COUNTY,  
PEER APPROVED 10/12/94  
CHAIRMAN *Harry Thubert*

The selected location is accepted by me and is generally accepted by professional surveyors as the best available evidence of the position of the original corner.

C. Description of monument for corner and accessories established to perpetuate locating the position of the corner:

A-6 Standard Kent County Monument  
C/L top of City benchmark #106 S 40° W 40.77'  
C/L top of hyd. #6N 55° W 38.20'  
SW cor. bndn. hse. #5N 45° E 56.21'  
NW cor. conc. block bldg. 0.2' above walk S 45° E 48.96'  
Kent County Monument E 1/4 cor. Sec. 13 T7N R12W N 00° E 4.01'

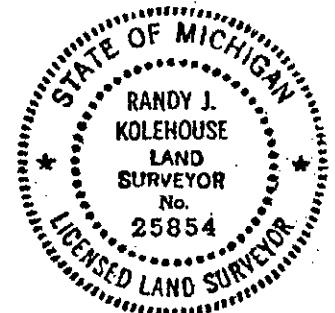

Signed by *Randy J. Kolehouse*  
Surveyor's Michigan License No. 25854

Date 12/1/94