

SURVEY & REMONUMENTATION

STATE OF MICHIGAN
COUNTY OF KENT
RECEIVED FOR RECORD

APR 28 1995

LAND CORNER RECORDATION CERTIFICATE

DEC -6 AM 8:59

Filing Requirement of Act 74, Mich. P.A. 1970

KENT COUNTY REMONUMENTATION

For corners in

COMMISSION

Kent
(County)

Located in:

Corner Code #

- | | | | |
|------------------------------------|-------------|--------------|------------|
| 1. Public Land Survey | T <u>7N</u> | R <u>11W</u> | <u>A-9</u> |
| | T _____ | R _____ | _____ |
| | T _____ | R _____ | _____ |
| | T _____ | R _____ | _____ |
| 2. Property Controlling in Section | S _____ | T _____ | R _____ |
| | S _____ | T _____ | R _____ |
| 3. Miscellaneous Property in Sec. | S _____ | T _____ | R _____ |
| | S _____ | T _____ | R _____ |

Teri J. Bond
REG. OF DEEDS

7762

Register of Deeds Stamp & File Number

4. Lot No. _____, Recorded Plat _____
5. Private Claims _____

	A	B	C	D	E	F	G	H	I	J	K	L	M
2	6		5		4		3		2		1		
3													
4	7		8		9		10		11		12		
5													
6	13		17		16		15		14		13		
7													
8	19		20		21		22		23		24		
9													
10	30		29		28		27		26		25		
11													
12	31		32		33		34		35		36		
13													

I, Randy Kolehouse, in a field survey on June 13 19 94, do hereby certify that under requirements of P.A. 74 Michigan P.A. of 1970, the corner points mentioned in lines 1 and 2 above were in conformance with regulations and rules therefore as required in the current manual of survey instructions of the United States Department of the Interior, Bureau of Land Management or by a decree of a Court of Law and/or that the corner points mentioned in lines 3, 4 and 5 above were in conformance with the rules of the Michigan Board of Land Surveyors or by a Decree of a Court of Law; established, re-established, monumented, re-monumented, recovered, found as expressed below:

NOTE: Not more than 4 corners, all in the same town and range, may be recorded on this certificate.

A. Description of original monument and accessories and/or subsequent restoration:

A-9 This corner was not originally set by the G.L.O.
N/A survey records Williams & Works City iron
1982 L.C.R.C. #3110 Williams & Works Fnd City iron/set PK s/tag

This corner was originally approved by the Kent County Remonumentation Peer Group and monumented by Williams & Works on 10/13/82 and was recorded per L.C.R.C. #3110.

B. Description of corner evidence found and/or method applied in restoring or reestablishing corner:

A-9 Found a capped rebar (KC remon.) in the C/L of Michigan St. E-W & Division Ave. South which was set in place of a P.K. tag set by Williams & Works over the top of a City iron they found which checks with Williams & Works and City of G.R. survey records.

L.C.R.C. #3110


NW corner stone building at concrete walk S 32° E 61.61'
NE corner concrete guard rail S 32° W 43.51'
SE corner concrete guard rail N 38° W 50.73'
West edge M.H. rim E 0.52'
Corner is on center line Michigan Street E & W and on C/L Division Ave. South

P.A. 345 1990 KENT COUNTY
PEER APPROVED 11/17/94
CHAIRMAN *Harry Huber*

The selected location is accepted by me and is generally accepted by professional surveyors as the best available evidence of the position of the original corner.

C. Description of monument for corner and accessories established to perpetuate locating the position of the corner:

A-9 1/2" Rebar with KC Remon. Cap
NW corner stone building at concrete walk S 32° E 61.61'
NE corner concrete guard rail S 32° W 43.51'
SE corner concrete guard rail N 38° W 50.73'
West edge M.H. rim E 0.52'
Corner is on center line Michigan Street E & W and on C/L Division Ave. South

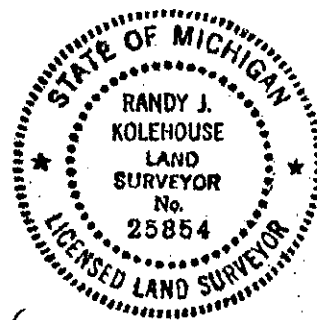

Signed by Randy Kolehouse Date 12/1/94
Surveyor's Michigan License No. 25854