

SURVEY & REMONUMENTATION

APR 28 1995

LAND CORNER RECORDATION CERTIFICATE

STATE OF MICHIGAN
COUNTY OF KENT
RECEIVED FOR RECORD

94 DEC -6 AM 8:59

COMMISSION Filing Requirement of Act 74, Mich. P.A. 1970
KENT COUNTY REMONUMENTATION

For corners in
Kent

Lee J. Bond
REG. OF DEEDS

For corners in Kent <small>(County)</small>	Located In:	Corner Code #:	
1. Public Land Survey	T <u>7N</u> R <u>11W</u>	<u>A-11</u>	
	T _____ R _____	_____	
	T _____ R _____	_____	
	T _____ R _____	_____	
2. Property Controlling in Section	S _____ T _____ R _____	_____	
	S _____ T _____ R _____	_____	
3. Miscellaneous Property in Sec.	S _____ T _____ R _____	_____	
	S _____ T _____ R _____	_____	

7764

Register of Deeds Stamp & File Number

4. Lot No. _____, Recorded Plat _____
5. Private Claims _____

	A	B	C	D	E	F	G	H	I	J	K	L	M
2	6	5	4	3	2	1							
3													
4	7	8	9	10	11	12							
5													
6	18	17	16	15	14	13							
7													
8	19	20	21	22	23	24							
9													
10	30	29	28	27	26	25							
11													
12	31	32	33	34	35	36							
13													

I, Randy Kolehouse, in a field survey on June 8, 1994, do hereby certify that under requirements of P.A. 74, Michigan P.A. of 1970, the corner points mentioned in lines 1 and 2 above were in conformance with regulations and rules therefore as required in the current manual of survey instructions of the United States Department of the Interior, Bureau of Land Management or by a decree of a Court of Law and/or that the corner points mentioned in lines 3, 4 and 5 above were in conformance with the rules of the Michigan Board of Land Surveyors or by a Decree of a Court of Law; established, re-established, monumented, re-monumented, recovered, found as expressed below:

NOTE: Not more than 4 corners, all in the same town and range, may be recorded on this certificate.

A. Description of original monument and accessories and/or subsequent restoration:

A-11	1831	G.L.O. Notes	L. Lyon	Set post
	N/A	Survey records	City of G.R.	City iron
	1938	Survey records	E.H. Christ	City iron
	1985	L.C.R.C. #4281	William Byl	Set KC mon.

P.A. 345 1990 KENT COUNTY
PEER APPROVED 10/12/94
CHAIRMAN *Frank Huber*

The position of this corner was previously approved by the Kent County Remonumentation Peer Group and monumented by William Byl on 5/29/85 and was recorded per L.C.R.C. #4281.

B. Description of corner evidence found and/or method applied in restoring or reestablishing corner:

A-11 Found KC Monument in the centerline intersection of Division Ave. N-S and Fulton Street E-W as set by William Byl using Doran Assessor's Plat No. 2, L 43 P 11, 1938.


L.C.R.C. #4281

- "V" cut in SE cor. of base of post N 45° W 47.22'
- "V" cut in face of conc. street light pole N 60° E 53.92'
- "+" cut in top of NW bolt of traffic signal pole base S 70° E 79.93'
- SW cor. of brick veneer of building at walk grade S 35° E 83.62'
- Face of Hyd. jacket at walk grade S 25° W 56.45'

The selected location is accepted by me and is generally accepted by professional surveyors as the best available evidence of the position of the original corner.

C. Description of monument for corner and accessories established to perpetuate locating the position of the corner:

- A-11 Standard Kent County Monument
- "V" cut in SE cor. of base of post N 45° W 47.22'
 - "V" cut in face of conc. street light pole N 60° E 53.92'
 - "+" cut in top of NW bolt of traffic signal pole base S 70° E 79.93'
 - SW cor. of brick veneer of building at walk grade S 35° E 83.62'
 - Face of Hyd. jacket at walk grade S 25° W 56.45'

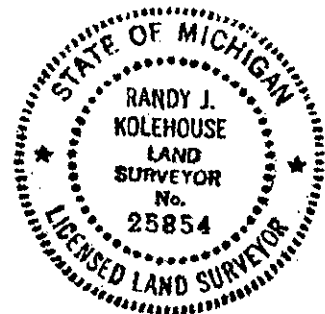

Signed by *Randy J. Kolehouse* Date 12/1/94
Surveyor's Michigan License No. 25854