

SURVEY & REMONUMENTATION

APR 28 1995

COMMISSION

LAND CORNER RECORDATION CERTIFICATE
Filing Requirement of Act 74, Mich. P.A. 1970
KENT COUNTY REMONUMENTATION

STATE OF MICHIGAN
 COUNTY OF KENT
 RECEIVED FOR RECORD

94 DEC 29 AM 11:12

W. J. Bond
 REG. OF DEEDS

7946

Register of Deeds Stamp & File Number

For corners in Kent (County) Located in: Corner Code #

1. Public Land Survey	T <u>7N</u> R <u>11W</u>	<u>B-10</u>
	T _____ R _____	_____
	T _____ R _____	_____
	T _____ R _____	_____
2. Property Controlling in Section	S _____ T _____ R _____	_____
	S _____ T _____ R _____	_____
3. Miscellaneous Property in Sec.	S _____ T _____ R _____	_____
	S _____ T _____ R _____	_____

4. Lot No. _____, Recorded Plat _____

5. Private Claims _____

A	B	C	D	E	F	G	H	I	J	K	L	M
2	6	5	4	3	2	1						
3												
4	7	8	9	10	11	12						
5												
6	16	17	18	15	14	13						
7												
8	19	20	21	22	23	24						
9												
10	26	28	27	26	25							
11												
12	31	32	33	34	35	36						
13												

I, Randy Kolehouse, in a field survey on September 29 19 94, do hereby certify that under requirements of P.A. 74 Michigan P.A. of 1970, the corner points mentioned in lines 1 and 2 above were in conformance with regulations and rules therefore as required in the current manual of survey instructions of the United States Department of the Interior, Bureau of Land Management or by a decree of a Court of Law and/or that the corner points mentioned in lines 3, 4 and 5 above were in conformance with the rules of the Michigan Board of Land Surveyors or by a Decree of a Court of Law; established, re-established, monumented, re-monumented, recovered, found as expressed below:

NOTE: Not more than 4 corners, all in the same town and range, may be recorded on this certificate.

A. Description of original monument and accessories and/or subsequent restoration:

B-10 This corner was not originally set by the G.L.O.

No record of corner evidence was found.

P.A. 345 1990 KENT COUNTY
 PEER APPROVED 11/3/94
 CHAIRMAN *Harry Huber*

B. Description of corner evidence found and/or method applied in restoring or reestablishing corner:


B-10 Re-established corner using ties to corner shown in Gays Subdivision L. 17 P. 5 (1900±). This point falls in the C/L of Fulton Street running E-W and is 0.2' East and 1.9' North of the intersection of 1/4 lines.

The selected location is accepted by me and is generally accepted by professional surveyors as the best available evidence of the position of the original corner.

C. Description of monument for corner and accessories established to perpetuate locating the position of the corner:

B-10 Set 1/2" rebar with "Kent County Remon." cap in pavement.

- P.K. nail & K.C. remon. tag in NW side 10" Ash N 70° E 67.64'
- P.K. nail & K.C. remon. tag in SW side 10" Ash N 65° W 70.91'
- Nail & K.C. remon. tag in NE side 18" Maple S 50° E 74.46'
- C/L M.B.T. M.H. cover S 20° E 5.72'
- C/L storm M.H. cover N 85° W 34.21'

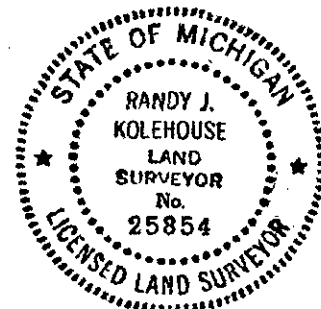

Signed by *Randy J. Kolehouse* Date 12/12/94
 Surveyor's Michigan License No. 25854