

STATE OF MICHIGAN  
COUNTY OF KENT  
RECEIVED FOR RECORD

05 MAR 24 AM 11:15

LAND CORNER RECORDATION CERTIFICATE

Filing Requirement of Act 74, Mich. P.A. 1970

KENT COUNTY REMONUMENTATION

For corners in

Kent (County)	Located in:	Corner Code #
1. Public Land Survey	T <u>7N</u> R <u>11W</u>	<u>C-2</u>
	T _____ R _____	_____
	T _____ R _____	_____
	T _____ R _____	_____
2. Property Controlling in Section	S _____ T _____ R _____	_____
	S _____ T _____ R _____	_____
3. Miscellaneous Property in Sec.	S _____ T _____ R _____	_____
	S _____ T _____ R _____	_____

*W. J. K.*

REG. OF DEEDS


Sequence #2

8341

Register of Deeds Stamp & File Number

4. Lot No. \_\_\_\_\_, Recorded Plat \_\_\_\_\_  
5. Private Claims \_\_\_\_\_

I, Randy Kolehouse, in a field survey on July 5 19 94, do hereby certify that under requirements of P.A. 74 Michigan P.A. of 1970, the corner points mentioned in lines 1 and 2 above were in conformance with regulations and rules therefore as required in the current manual of survey instructions of the United States Department of the interior, Bureau of Land Management or by a decree of a Court of Law and/or that the corner points mentioned in lines 3, 4 and 5 above were in conformance with the rules of the Michigan Board of Land Surveyors or by a Decree of a Court of Law; established, re-established, monumented, re-monumented, recovered, found as expressed below:

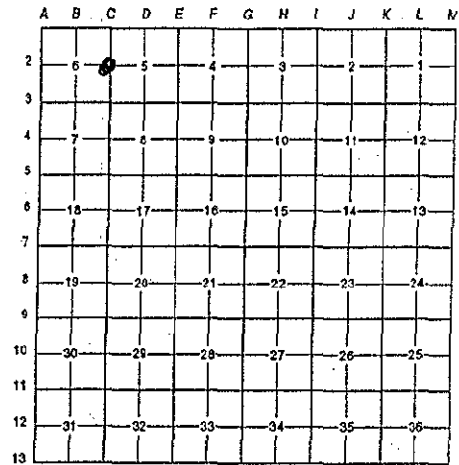

NOTE: Not more than 4 corners, all in the same town and range, may be recorded on this certificate.

A. Description of original monument and accessories and/or subsequent restoration:

C-2	1831	G.L.O. Notes	Mullett	Set Post
	1915-1961	Survey Records	Williams & Works	Concrete Monument
	1985	L.C.R.C. #4241	William R. Byl	Set K.C. Mon. Over Top of Conc. Mon.
	1988	L.C.R.C. #4566	Bueche	K.C. Mon.

This corner was originally approved by the Kent County Remonumentation Peer Group and monumented by William R. Byl on 5/20/85 and was recorded per L.C.R.C. #4241.

B. Description of corner evidence found and/or method applied in restoring or reestablishing corner:

C-2 Found standard Kent County Monument per L.C.R.C.'s #4241 and #4566 as set by William R. Byl over a concrete plat monument he found which checked Williams & Works survey records.

L.C.R.C. #4241

L.C.R.C. #4566

P.A. 345 1990 KENT COUNTY

PEER APPROVED 11/17/94

CHAIRMAN *[Signature]*


NW cor. garage fndn. S 45° E 66.11'  
NW cor. fndn. hse. #805 S 20° E 61.28'  
Nail & tag W side 16" Oak N 45° E 13.65'  
Chain link R/W fence N 00° E 1.50'

NW cor. garage fndn. S 45° E 66.11'  
NW cor. fndn. hse. #805 S 20° E 61.28'  
Nail & tag W side 16" Oak N 45° E 13.65'  
Chain link R/W fence N 00° E 1.50'

The selected location is accepted by me and is generally accepted by professional surveyors as the best available evidence of the position of the original corner.

C. Description of monument for corner and accessories established to perpetuate locating the position of the corner:

C-2 Standard Kent County Monument  
NW cor. garage fndn. S 45° E 66.11'  
NW cor. fndn. hse. #805 S 20° E 61.28'  
Nail & K.C. remon. tag W side 16" Oak N 45° E 13.65'  
Chain link R/W fence N 00° E 1.50'

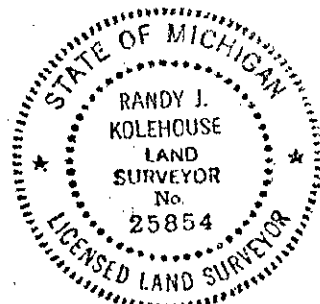

Signed by *Randy J. Kolehouse* Date 3/20/95  
Surveyor's Michigan License No. 25854