

SURVEY & REMONUMENTATION

APR 28 1995

LAND CORNER RECORDATION CERTIFICATE
Filing Requirement of Act 74, Mich. P.A. 1970
KENT COUNTY REMONUMENTATION

STATE OF MICHIGAN
COUNTY OF KENT
RECEIVED FOR RECORD

94 DEC -6 AM 9:00

For corners in **COMMISSION**

<u>Kent</u> (County)	Located in:	Corner Code #	
1. Public Land Survey	T <u>7N</u> R <u>11W</u>	<u>C-6</u>	_____
	T _____ R _____	_____	_____
	T _____ R _____	_____	_____
	T _____ R _____	_____	_____
2. Property Controlling in Section	S _____ T _____ R _____	_____	_____
	S _____ T _____ R _____	_____	_____
3. Miscellaneous Property in Sec.	S _____ T _____ R _____	_____	_____
	S _____ T _____ R _____	_____	_____


W. J. Bond
REG. OF DEEDS

7778

Register of Deeds Stamp & File Number

4. Lot No. _____, Recorded Plat _____
5. Private Claims _____

I, Randy Kolehouse, in a field survey on July 21 19 94, do hereby certify that under requirements of P.A. 74 Michigan P.A. of 1970, the corner points mentioned in lines 1 and 2 above were in conformance with regulations and rules therefore as required in the current manual of survey instructions of the United States Department of the interior, Bureau of Land Management or by a decree of a Court of Law and/or that the corner points mentioned in lines 3, 4 and 5 above were in conformance with the rules of the Michigan Board of Land Surveyors or by a Decree of a Court of Law; established, re-established, monumented, re-monumented, recovered, found as expressed below:

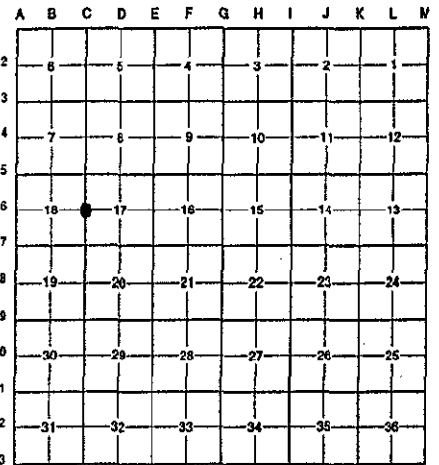

NOTE: Not more than 4 corners, all in the same town and range, may be recorded on this certificate.

A. Description of original monument and accessories and/or subsequent restoration:

C-6	1831	G.L.O. Notes	Mullett	Set Post
	1906-1971	Survey Records	Williams & Works	City Iron/Conc. Mon.
	N/A	Survey Records	City of Grand Rapids	Stone Monument
	1984	L.C.R.C. #3914	William R. Byl	Fnd. Conc. Mon./Set K.C. Mon.
	1988	L.C.R.C. #4669	Bueche	K.C. Mon.

P.A. 345 1990 KENT COUNTY

PEER APPROVED 11/3/94
CHAIRMAN *Harry Thibault*

This corner was originally approved by the Kent County Remonumentation Peer Group and monumented by William R. Byl on 8/20/84 and was recorded per L.C.R.C. #3914.

B. Description of corner evidence found and/or method applied in restoring or reestablishing corner:

C-6 Found standard Kent County Monument per L.C.R.C.'s #3914 and #4669 as set by William R. Byl in place of a 4"x48" concrete monument he found which checked City of Grand Rapids and Williams & Works survey records.

L.C.R.C. #3914

L.C.R.C. #4669


SE cor. of garage (siding) at grade N 85° E 117.46'
NW cor. of brick hse. at grade N 25° E 113.66'
Nail & tag N side 36" Twin Oak N 85° W 16.09'
Face of 3" fence post N 00° E 3.67'

SE cor. of garage (siding) at grade N 85° E 117.46'
NW cor. of brick hse. at grade N 25° E 113.66'
Nail & tag N side 36" Twin Oak N 85° W 16.09'
Nail & tag 14" Cherry N 05° E 26.90'
Face of 3" fence post N 00° E 3.67'

The selected location is accepted by me and is generally accepted by professional surveyors as the best available evidence of the position of the original corner.

C. Description of monument for corner and accessories established to perpetuate locating the position of the corner:

C-6 Standard Kent County Monument
SE cor. of garage (siding) at grade N 85° E 117.46'
NW cor. of brick hse. at grade N 25° E 113.66'
Nail & K.C. remon. tag N side 36" Twin Oak N 85° W 16.09'
Nail & K.C. remon. tag 14" Cherry N 05° E 26.90'
Face of 3" fence post N 00° E 3.67'

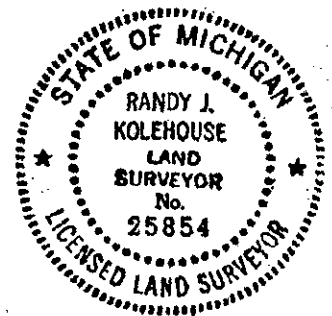

Signed by *Randy J. Kolehouse*
Surveyor's Michigan License No. 25854

Date 12/1/94