

SURVEY & REMONUMENTATION

APR 28 1995

COMMISSION

LAND CORNER RECORDATION CERTIFICATE
 Filing Requirement of Act 74, Mich. P.A. 1970
 KENT COUNTY REMONUMENTATION

STATE OF MICHIGAN
 COUNTY OF KENT
 RECEIVED FOR RECORD

94 DEC -6 AM 9:00


W. J. Bond
 REG. OF DEEDS

For corners in

Kent (County)	Located in:	Corner Code #
1. Public Land Survey	T <u>7N</u> R <u>11W</u>	<u>C-9</u>
	T _____ R _____	_____
	T _____ R _____	_____
	T _____ R _____	_____
2. Property Controlling in Section	S _____ T _____ R _____	_____
	S _____ T _____ R _____	_____
3. Miscellaneous Property in Sec.	S _____ T _____ R _____	_____
	S _____ T _____ R _____	_____

7781
 Register of Deeds Stamp & File Number

4. Lot No. _____, Recorded Plat _____
 5. Private Claims _____

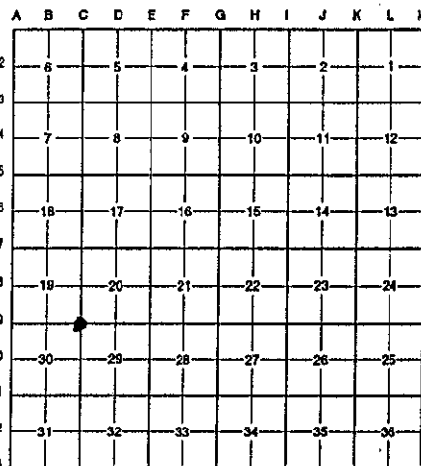

I, Randy Kolehouse, in a field survey on June 13 19 94, do hereby certify that under requirements of P.A. 74 Michigan P.A. of 1970, the corner points mentioned in lines 1 and 2 above were in conformance with regulations and rules therefore as required in the current manual of survey instructions of the United States Department of the Interior, Bureau of Land Management or by a decree of a Court of Law and/or that the corner points mentioned in lines 3, 4 and 5 above were in conformance with the rules of the Michigan Board of Land Surveyors or by a Decree of a Court of Law; established, re-established, monumented, re-monumented, recovered, found as expressed below:

NOTE: Not more than 4 corners, all in the same town and range, may be recorded on this certificate.

A. Description of original monument and accessories and/or subsequent restoration:

C-9	1831	G.L.O. Notes	Mullett	Set Post
	N/A	Survey Records	City of Grand Rapids	City Iron
	1984	L.C.R.C. #3714	Exxel Engineering	P.K. Nail
	1984	L.C.R.C. #3777	William R. Byl	Set K.C. Monument
	1988	L.C.R.C. #4596	Bueche	K.C. Monument

P.A. 345 1990 KENT COUNTY
 PEER APPROVED 11/3/94
 CHAIRMAN *[Signature]*

This corner was originally approved by the Kent County Remonumentation Peer Group and monumented by William R. Byl on 2/16/84 and was recorded per L.C.R.C. #3777.

B. Description of corner evidence found and/or method applied in restoring or reestablishing corner:

C-9 Found standard Kent County Monument at C/L of Michigan Street E-W and Eastern Avenue N-S per L.C.R.C.'s #3777 and #4596 as set by William Byl using City of Grand Rapids survey records (P.K. in L.C.R.C. #3714 was 0.16' West and 0.07' South).

L.C.R.C. #3777

L.C.R.C. #4596

Cut mark in NE cor. brick bldg. S 45° E 46.05'
 C/L brass capped benchmark (City of G.R.) S 45° E 41.71'
 SE cor. concrete signpost base (at walk level) N 45° W 45.34'

Cut mark in NE cor. brick bldg. S 45° E 46.05'
 C/L brass capped benchmark (City of G.R.) S 45° E 41.71'
 SE cor. concrete signpost base (at walk level) N 45° W 45.34'
 Face of conc. lt. pole @ base S 50° E 41.35'
 SW cor. bldg. @ brick N 30° E 113.48'

The selected location is accepted by me and is generally accepted by professional surveyors as the best available evidence of the position of the original corner.

C. Description of monument for corner and accessories established to perpetuate locating the position of the corner:

C-9 Standard Kent County Monument
 Cut mark in NE cor. brick bldg. S 45° E 46.05'
 C/L brass capped benchmark (City of G.R.) S 45° E 41.71'
 SE cor. concrete signpost base (at walk level) N 45° W 45.34'
 Face of conc. lt. pole @ base S 50° E 41.35'
 SW cor. bldg. @ brick N 30° E 113.48'



Signed by *Randy J. Kolehouse* Date 12/1/94
 Surveyor's Michigan License No. 25854