

**SURVEY & REMONUMENTATION**

SEP 03 1999

STATE OF MICHIGAN  
COUNTY OF KENT  
RECEIVED FOR RECORD

94 DEC 29 AM 11:12

**SECTION**

**LAND CORNER RECORDATION CERTIFICATE**  
Filing Requirement of Act 74, Mich. P.A. 1970  
KENT COUNTY REMONUMENTATION

For corners in

Kent (County)	Located in:	Corner Code #
1. Public Land Survey	T <u>7N</u> R <u>11W</u>	<u>D-2</u>
	T _____ R _____	_____
	T _____ R _____	_____
	T _____ R _____	_____
2. Property Controlling in Section	S _____ T _____ R _____	_____
	S _____ T _____ R _____	_____
3. Miscellaneous Property in Sec.	S _____ T _____ R _____	_____
	S _____ T _____ R _____	_____


*W. J. Bond*  
REG. OF DEEDS

7948

Register of Deeds Stamp & File Number

4. Lot No. \_\_\_\_\_, Recorded Plat \_\_\_\_\_  
5. Private Claims \_\_\_\_\_

I, Randy Kolehouse, in a field survey on December 1 19 94, do hereby certify that under requirements of P.A. 74 Michigan P.A. of 1970, the corner points mentioned in lines 1 and 2 above were in conformance with regulations and rules therefore as required in the current manual of survey instructions of the United States Department of the interior, Bureau of Land Management or by a decree of a Court of Law and/or that the corner points mentioned in lines 3, 4 and 5 above were in conformance with the rules of the Michigan Board of Land Surveyors or by a Decree of a Court of Law; established, re-established, monumented, re-monumented, recovered, found as expressed below:

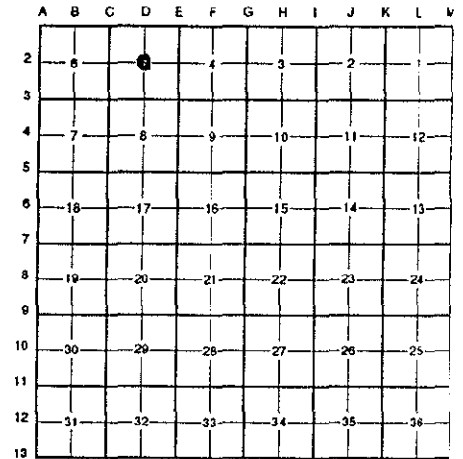

**NOTE: Not more than 4 corners, all in the same town and range, may be recorded on this certificate.**

A. Description of original monument and accessories and/or subsequent restoration:

D-2 This corner was not originally set by the G.L.O.

1906	Survey Records	Williams & Works	Fence Corner
1922	Survey Records	Williams & Works	Iron
1939	Survey Records	Williams & Works	Plat Monument
1939-1959	Survey Records	Williams & Works	Plat Monument

B. Description of corner evidence found and/or method applied in restoring or reestablishing corner:

D-2 In the early 1960's MDSH constructed I-96 and destroyed the plat monument as shown in Williams & Works survey records of 1939-1959. This monument was the NE corner of Soft Water Lake Plat (1924). Center of Section now falls in the Eastbound lane and I-96. Set reference monument 95.00 feet south of Center.

P.A. 345 1990 KENT COUNTY  
PEER APPROVED 12/11/94  
CHAIRMAN *Harvey Huber*

The selected location is accepted by me and is generally accepted by professional surveyors as the best available evidence of the position of the original corner.

C. Description of monument for corner and accessories established to perpetuate locating the position of the corner:

D-2 Set a Standard 4" x 30" Kent County Reference Monument 95.00 feet South of the Center Section.

- Nail & K.C. remon. tag in S side 8" Maple S 60° E 46.53'
- Nail & K.C. remon. tag in SW side 18" Oak S 40° E 31.09'
- Nail & K.C. remon. tag in E side 8" Maple S 05° E 39.68'
- Nail & K.C. remon. tag in E side 12" Red Pine S 15° W 16.20'
- NE corner hse. fndn. S 65° W 23.39'



Signed by Randy J. Kolehouse Date 12/12/94  
Surveyor's Michigan License No. 25854