

SURVEY & REMONUMENTATION

APR 28 1995

COMMISSION

STATE OF MICHIGAN
COUNTY OF KENT
RECEIVED FOR RECORD

LAND CORNER RECORDATION CERTIFICATE
Filing Requirement of Act 74, Mich. P.A. 1970
KENT COUNTY REMONUMENTATION

DEC 29 AM 11:12

For corners in

Kent (County)	Located in:	Corner Code #
1. Public Land Survey	T <u>7N</u> R <u>11W</u>	<u>D-4</u>
	T _____ R _____	_____
	T _____ R _____	_____
	T _____ R _____	_____
2. Property Controlling in Section	S _____ T _____ R _____	_____
	S _____ T _____ R _____	_____
3. Miscellaneous Property in Sec.	S _____ T _____ R _____	_____
	S _____ T _____ R _____	_____

Lee J. Bond
REG. OF DEEDS

7949

Register of Deeds Stamp & File Number

4. Lot No. _____, Recorded Plat _____
5. Private Claims _____

A	B	C	D	E	F	G	H	I	J	K	L	M
2	6	5	4	3	2	1						
3												
4	7	●	9	10	11	12						
5												
6	18	17	16	15	14	13						
7												
8	19	20	21	22	23	24						
9												
10	30	29	28	27	26	25						
11												
12	31	32	33	34	35	36						
13												

I, Randy Kolehouse, in a field survey on November 19 94, do hereby certify that under requirements of P.A. 74 Michigan P.A. of 1970, the corner points mentioned in lines 1 and 2 above were in conformance with regulations and rules therefore as required in the current manual of survey instructions of the United States Department of the Interior, Bureau of Land Management or by a decree of a Court of Law and/or that the corner points mentioned in lines 3, 4 and 5 above were in conformance with the rules of the Michigan Board of Land Surveyors or by a Decree of a Court of Law; established, re-established, monumented, re-monumented, recovered, found as expressed below:

NOTE: Not more than 4 corners, all in the same town and range, may be recorded on this certificate.

A. Description of original monument and accessories and/or subsequent restoration:

D-4 This corner was not originally set by the G.L.O.

1895-1937	Survey Records	Williams & Works	Stone
1944-1963	Survey Records	Williams & Works	City Iron
1964	Survey Records	Williams & Works	Reset Corner
N/A	Survey Records	Exxel Engineering	P.K. Nail

B. Description of corner evidence found and/or method applied in restoring or reestablishing corner:

D-4 Found capped iron at 2' East of E/L of Fuller Avenue running N-S on C/L of Aberdeen Street running E-W which checks Williams & Works survey records 1928-1938. Also checks Exxel Engineering survey records. Iron is 0.7' North and 1.2' East of intersection of 1/4 lines. Accepted iron as Center Section.


P.A. 345 1990 KENT COUNTY
PEER APPROVED 11/3/94
CHAIRMAN *Harry Huber*

The selected location is accepted by me and is generally accepted by professional surveyors as the best available evidence of the position of the original corner.

C. Description of monument for corner and accessories established to perpetuate locating the position of the corner:

D-4 Replaced iron with Standard 4" x 30" Kent County Monument.

- Nail & K.C. remon. tag in NW side p. pole N 55° E 40.91'
- Nail & K.C. remon. tag in S side 28" Birch S 80° E 135.85'
- Nail & K.C. remon. tag in SW side p. pole S 05° E 122.99'
- Nail & K.C. remon. tag in S side 14" Maple S 75° W 74.57'
- Nail & K.C. remon. tag in S side 14" Maple N 70° W 68.16'
- Top C/L hyd. N 65° W 58.79'

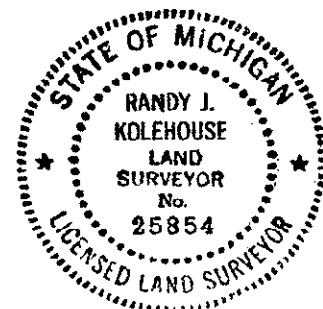

Signed by Randy J. Kolehouse Date 12/12/94
Surveyor's Michigan License No. 25854